


**LAND CORNER RECORDATION CERTIFICATE**  
 Filing Requirement of Act 74, Mich. P.A. 1970

For corners in

|                                       |             |               |
|---------------------------------------|-------------|---------------|
| <u>ONTONAGON</u><br>(County)          | Located In: | Corner Code # |
| 1. Public Land Survey                 | T 48NR 39W  | I-7           |
|                                       | T R         |               |
|                                       | T R         |               |
|                                       | T R         |               |
| 2. Property Controlling<br>in Section | S T R       |               |
|                                       | S T R       |               |
| 3. Miscellaneous<br>Property in Sec.  | S T R       |               |
|                                       | S T R       |               |

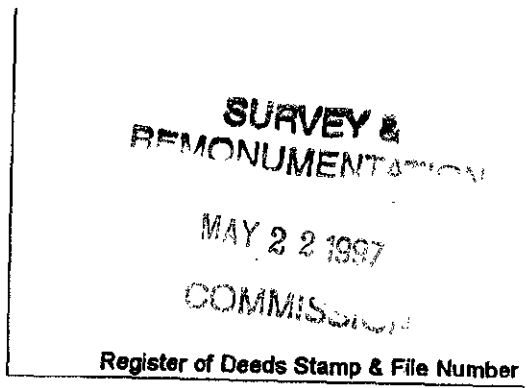

4. Lot No. \_\_\_\_\_, Recorded Plat \_\_\_\_\_  
 5. Private Claims \_\_\_\_\_

Section Corner common to Sections 14, 15, 22 & 23, T48N R39W.

I, Earl W. Applekamp, in a field survey on Sept. 30, 1996 do hereby state that under requirements of P.A. 74, Michigan P.A. of 1970, the corner points mentioned in lines 1 and 2 above were in conformance with regulations and rules therefore as required in the current manual of survey instructions of the United States Department of the Interior, Bureau of Land Management or by a decree of a Court of Law and/or that the corner points mentioned in lines 3, 4 and 5 above were in conformance with the rules of the Michigan Board of Land Surveyors or by a Decree of a Court of Law; established, re-established, monumented, recovered, found as expressed below:

NOTE: Not more than 2 corners, all in the same town and range, may be recorded on this certificate.

| A  | B  | C | D  | E | F  | G | H  | I | J  | K | L  | M |
|----|----|---|----|---|----|---|----|---|----|---|----|---|
| 1  |    |   |    |   |    |   |    |   |    |   |    |   |
| 2  | 6  |   | 5  |   | 4  |   | 3  |   | 2  |   | 1  |   |
| 3  |    |   |    |   |    |   |    |   |    |   |    |   |
| 4  | 7  |   | 8  |   | 9  |   | 10 |   | 11 |   | 12 |   |
| 5  |    |   |    |   |    |   |    |   |    |   |    |   |
| 6  | 18 |   | 17 |   | 16 |   | 15 |   | 14 |   | 13 |   |
| 7  |    |   |    |   |    |   |    |   |    |   |    |   |
| 8  | 19 |   | 20 |   | 21 |   | 22 |   | 23 |   | 24 |   |
| 9  |    |   |    |   |    |   |    |   |    |   |    |   |
| 10 | 30 |   | 29 |   | 28 |   | 27 |   | 26 |   | 25 |   |
| 11 |    |   |    |   |    |   |    |   |    |   |    |   |
| 12 | 31 |   | 32 |   | 33 |   | 34 |   | 35 |   | 36 |   |
| 13 |    |   |    |   |    |   |    |   |    |   |    |   |

A. Description of original monument and accessories and/or subsequent restoration:

Original corner established by Artemas Curtis, U.S. Deputy Surveyor, September 23, 1851. Set Wood Post.

ORIGINAL BEARING TREES:

Cedar 12" N60°W 8.58 feet  
 Cedar 12" S25°E 7.92 feet

PEER GROUP APPROVED  
Earl W. Applekamp  
 COUNTY REPRESENTATIVE 10-16-96

B. Description of corner evidence found and/or method applied in restoring or reestablishing corner:

No original evidence was found. At the calculated corner position there is an intersection of county roads, 1 Mile and Larson. This location is in agreement with creek calls given on the original field notes in all directions. The intersection of these roads is the only logical position for the corner as land is occupied by four different owners in the four directions. I re-established the corner at the intersection of these roads as described in "C" below.

Research on file with the Ontonagon County Remonumentation Program Representative.

C. Description of monument for corner and accessories established to perpetuate locating the position of the corner:

AT the corner position I set a 5/8"x21" iron rod with a 3/4" stamped aluminum cap, 6" below top of the gravel road. I established a reference monument, a 2 1/2"x30" aluminum pipe with a 3/4" cap stamped to read: County Remonumentation, T48N R39W, R.M., S14, S15, S22, S23, 1996, P.S. 17610. I established three other witness trees and objects.

REF. MON. S44°-50'-30"E 63.18' - 4" W. Pine N54°-52'-13"W 63.22'  
 P. Pole S33°-13'-27"W 50.85' - 5" Cedar N64°-11'-03"E 64.89'



Signed by Earl W. Applekamp  
 Surveyor's Michigan License No. 17610

Date October 2, 1996