

LAND CORNER RECORDATION CERTIFICATE
 Filing Requirement of Act 74, Mich. P.A. 1970

For corners in


ONTONAGON (County)	Located In:	Corner Code #
1. Public Land Survey	T48N R 39W	I-9
	T R	
	T R	
	T R	
2. Property Controlling in Section	S T R	
	S T R	
3. Miscellaneous Property in Sec.	S T R	
	S T R	

REMONUMENTATION
 OCT 30 1997
 COMMISSION
 Register of Deeds Stamp & File Number

4. Lot No. _____, Recorded Plat _____
 5. Private Claims _____

Section Corner common to Sections 22, 23, 26 & 27, T48N R39W.

I, Earl W. Applekamp, in a field survey on June 20, 1997 do hereby state that under requirements of P.A. 74, Michigan P.A. of 1970, the corner points mentioned in lines 1 and 2 above were in conformance with regulations and rules therefore as required in the current manual of survey instructions of the United States Department of the Interior, Bureau of Land Management or by a decree of a Court of Law and/or that the corner points mentioned in lines 3, 4 and 5 above were in conformance with the rules of the Michigan Board of Land Surveyors or by a Decree of a Court of Law, established, re-established, monumented, recovered, found as expressed below:

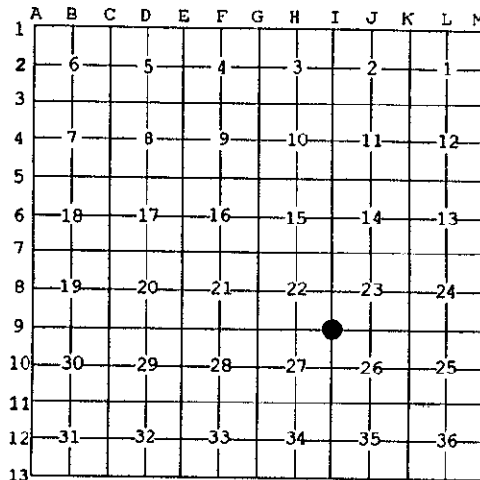

NOTE: Not more than 2 corners, all in the same town and range, may be recorded on this certificate.

A. Description of original monument and accessories and/or subsequent restoration:

Original corner established by Artemas Curtis, U.S. Deputy Surveyor, September 19, 1851. Set Wood Post.

ORIGINAL BEARING TREES:

6" Hemlock	N45°E	3.30 feet
10" Hemlock	S86°W	8.58 feet

B. Description of corner evidence found and/or method applied in restoring or reestablishing corner:

A 3/4" boat spike is in a monument box in Highway M-28. This is shown on highway drawings. Corner position is at an intersection of a North-South County road and Highway M-28. Numerous surveys have been performed from this corner location. Distances to opposite corners are in conformance with original field notes. I accepted the position as being the true location of the original.


Research on file with the Ontonagon County Remonumentation Program Representative.

PEER GROUP APPROVED
Earl W. Applekamp
 COUNTY REPRESENTATIVE
 7-15-97

C. Description of monument for corner and accessories established to perpetuate locating the position of the corner:

At the corner position is a 3/4" I.P. in a monument box in centerline of Highway M-28. I established two reference monuments. Both are 2 1/2"x30" aluminum pipe with a 3" cap stamped to read: County Remonumentation, T48N R39W, R.M., S22, S23, S26, S27, 1997, P.S. 17610. I established two other bearing objects.

REF. MON.	N38°-04'-06"E	81.86'	- Power Pole	S31°W	74.84'
REF. MON.	S39°-35'-43"E	86.36'	- Wood Stop Sign Post	N37°W	52.66'

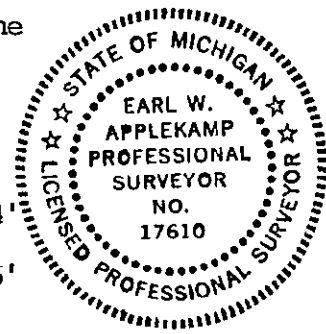

Signed by Earl W. Applekamp
 Surveyor's Michigan License No. 17610

Date June 28, 1997