

LAND CORNER RECORDATION CERTIFICATE
Filing Requirement of Act 74, Mich. P.A. 1970

For corners in


ONTONAGON (County)	Located In:	Corner Code #
1. Public Land Survey	T48N R39W	K-9
	T___ R___	_____
	T___ R___	_____
	T___ R___	_____
2. Property Controlling in Section	S___ T___ R___	_____
	S___ T___ R___	_____
3. Miscellaneous Property in Sec.	S___ T___ R___	_____
	S___ T___ R___	_____

REMONUMENTATION
OCT 9 9 1997
COMMISSION
Register of Deeds Stamp & File Number

4. Lot No. _____, Recorded Plat _____
5. Private Claims _____

Section Corner common to Sections 23, 24, 25 & 26, T48N R39W.

I, Earl W. Applekamp, in a field survey on June 20, 1997 do hereby state that under requirements of P.A. 74, Michigan P.A. of 1970, the corner points mentioned in lines 1 and 2 above were in conformance with regulations and rules therefore as required in the current manual of survey instructions of the United States Department of the Interior, Bureau of Land Management or by a decree of a Court of Law and/or that the corner points mentioned in lines 3, 4 and 5 above were in conformance with the rules of the Michigan Board of Land Surveyors or by a Decree of a Court of Law; established, re-established, monumented, recovered, found as expressed below:

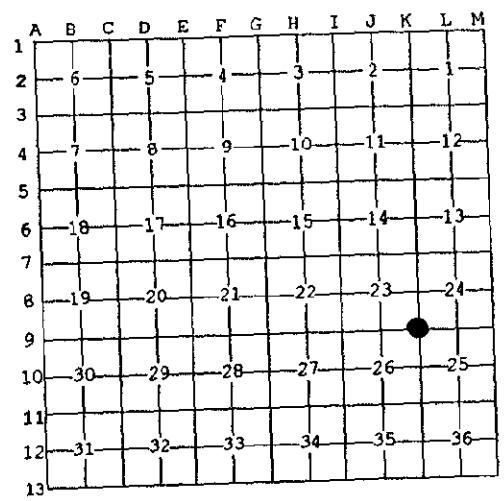

NOTE: Not more than 2 corners, all in the same town and range, may be recorded on this certificate.

A. Description of original monument and accessories and/or subsequent restoration:
Original corner established by Artemas Curtis, U.S. Deputy Surveyor, September 20, 1851. Set Wood Post.


ORIGINAL BEARING TREES:
18" Sugar Maple N25°W 29.04 feet
9" Hemlock S19°E 18.48 feet

PEER GROUP APPROVED
Earl W. Applekamp
COUNTY REPRESENTATIVE
7-15-97

B. Description of corner evidence found and/or method applied in restoring or reestablishing corner:
No original evidence was found. Michigan highway M-28 covers the corner. A survey in August 1964 by John Smallwood, P.S., a surveyor for MDOT accepted a 3/4" iron pin and used it for highway construction and land acquisition. This iron pin is in a monument box in the paved highway 9 feet South of the centerline. A county road runs North & South from this corner and shown on the highway drawings. Several surveys in the area have used this corner as control for the survey. I accepted the position as being the only logical position.

Research on file with the Ontonagon County Remonumentation Program Representative.

C. Description of monument for corner and accessories established to perpetuate locating the position of the corner:
At the corner position of a 3/4" I.P. is in a monument box 9 feet South of the centerline of highway M-28. I established two reference monuments which are 2 1/2" aluminum pipe with a 3" cap stamped to read: County Remonumentation, T48N R39W, R.M., S23, S24, S25, S26, 1997, P.S. 17610. I established two other reference objects.

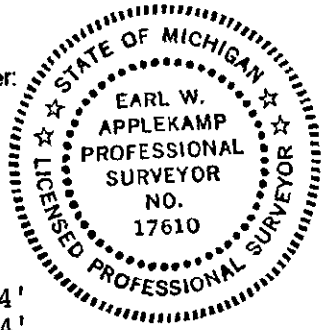

REF. MON.	S44°-12'-21"E	101.26'	-	17" Maple	N57°-36'-40"W	187.24'
REF. MON.	S36°-43'-13"W	98.25'	-	Power Pole	N67°-34'-58"E	221.14'

Signed by Earl W. Applekamp
Surveyor's Michigan License No. 17610

Date July 11, 1997