


LAND CORNER RECORDATION CERTIFICATE
 Filing Requirement of Act 74, Mich. P.A. 1970

For corners in

<u>ONTONAGON</u> (County)	Located in:	Corner Code #
1. Public Land Survey	T <u>48NR 39W</u>	<u>L-9</u>
	T ___ R ___	_____
	T ___ R ___	_____
	T ___ R ___	_____
2. Property Controlling in Section	S ___ T ___ R ___	_____
	S ___ T ___ R ___	_____
3. Miscellaneous Property in Sec.	S ___ T ___ R ___	_____
	S ___ T ___ R ___	_____

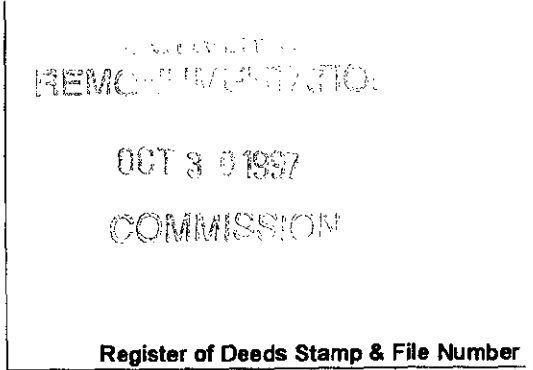

4. Lot No. _____, Recorded Plat _____
 5. Private Claims _____

1/4 Corner common to Sections 24 & 25, T48N R39W.

I, Earl W. Applekamp, in a field survey on June 13, 19 97 do hereby state that under requirements of P.A. 74, Michigan P.A. of 1970, the corner points mentioned in lines 1 and 2 above were in conformance with regulations and rules therefore as required in the current manual of survey instructions of the United States Department of the Interior, Bureau of Land Management or by a decree of a Court of Law and/or that the corner points mentioned in lines 3, 4 and 5 above were in conformance with the rules of the Michigan Board of Land Surveyors or by a Decree of a Court of Law; established, re-established, monumented, recovered, found as expressed below:

NOTE: Not more than 2 corners, all in the same town and range, may be recorded on this certificate.

	A	B	C	D	E	F	G	H	I	J	K	L	M
1													
2	6		5		4		3		2		1		
3													
4	7		8		9		10		11		12		
5													
6	18		17		16		15		14		13		
7													
8	19		20		21		22		23		24		
9													
10	30		29		28		27		26		25		
11													
12	31		32		33		34		35		36		
13													

A. Description of original monument and accessories and/or subsequent restoration:

Original corner established by Artemas Curtis, U.S. Deputy Surveyor, September 21, 1851. Set Wood Post.

ORIGINAL BEARING TREES:

30" Hemlock	N19°W	4.62 feet
15" Sugar Maple	S41°E	17.82 feet

B. Description of corner evidence found and/or method applied in restoring or reestablishing corner:

At the corner position a county blacktop road runs East & West. No original evidence remains or was found. Corner was re-established by single proportionate measure between opposite section corners East and West and in the centerline of the blacktop road.

Research on file with the Ontonagon County Remonumentation Program Representative.

PEER GROUP APPROVED
Earl W. Applekamp
 COUNTY REPRESENTATIVE
 7-15-97

C. Description of monument for corner and accessories established to perpetuate locating the position of the corner:

At the corner position I set a 5/8"X8" rebar with a 3" stamped cap 2" below the top of the blacktop road. I established a reference monument, a 2 1/2"X30" aluminum pipe with a 3" cap stamped to read: County Remonumentation, T48N R39W, R.M., S24, S25, 1997, P.S. 17610. I also established three other reference objects.

REF. MON.	S38°W	46.70 feet	- Guy Pole	N77°E	93.72 feet
Power Pole	N43°W	59.04 feet	- Power Pole	S63°E	61.83 feet



Signed by *Earl W. Applekamp*
 Surveyor's Michigan License No. 17610

Date June 23, 1997