

**SURVEY & REMONUMENTATION**

APR 29 1996

**LAND CORNER RECORDATION CERTIFICATE**  
**Filing Requirement of Act 74, Mich. P.A. 1970**

JUDITH D. ROEHM  
 Ontonagon County

07/19/95  
 10:07

LC 3/280 JEM

Fee: 9.00  
 Page 1 of 1

For corners in **COMMISSION**  
ONTONAGON  
 (County)

Located In:

Corner Code #

- 1. Public Land Survey      48 R 38 (&39)      A-11 & M-11  
     T      R  
     T      R  
     T      R
- 2. Property Controlling      S      T      R  
     in Section      S      T      R
- 3. Miscellaneous      S      T      R  
     Property in Section      S      T      R

Register of Deeds Stamp & File Number

- 4. Lot No. \_\_\_\_\_, Recorded Plat \_\_\_\_\_
- 5. Private Claims \_\_\_\_\_

Section Corner common to S30 & 31, T48N R38W & S25 & 36, T48N R39W.

I, Earl W. Applekamp, in a field survey on July 18, 1995, do hereby certify that under requirements of P.A. 74, Michigan P.A. of 1970, the corner points mentioned in lines 1 and 2 above were in conformance with regulations and rules therefore as required in the current manual of survey instructions of the United States Department of the Interior, Bureau of Land Management or by a decree of a Court of Law and/or that the corner points mentioned in lines 3, 4 and 5 above were in conformance with the rules of the Michigan Board of Professional Surveyors or by a Decree of a Court of Law; established, re-established, monumented, re-monumented, recovered, found as expressed below:

A	B	C	D	E	F	G	H	I	J	K	L	M
2	6	5	4	3	2							
3												
4	7	8	9	10	11	12						
5												
6	18	17	16	15	14	13						
7												
8	19	20	21	22	23	24						
9												
10	30	29	28	27	26	25						
11												
12	31	32	33	34	35	36						
13												

**NOTE: Not more than 4 corners, all in the same town and range, may be recorded on this certificate.**

**A. Description of original monument and accessories and/or subsequent restoration:**

Original Corner established by Artemas Curtis, U.S. Deputy Surveyor, July 1847. Set Hemlock Post.

**ORIGINAL BEARING TREES:**

- Hemlock 10"      S86°E      28 Links (18.48 feet)
- Sugar 12"      N83°E      18 Links (11.48 feet)


**PEER GROUP APPROVED**  
*Earl W. Applekamp*  
 COUNTY REPRESENTATIVE  
 7-18-95

**B. Description of corner evidence found and/or method applied in restoring or reestablishing corner:**

No evidence of original corner or bearing trees were found. At the corner position there was a 1/2" Iron Re-bar flush with the blacktop surface. There is a four way road intersection at the corner position. The 1/2" Iron Pin was used for several surveys in the area. I accepted the 1/2" Iron Pin as the corner location and remonumented the corner as described in "C" below.

**C. Description of monument for corner and accessories established to perpetuate locating the position of the corner:**

At the corner position I set a 3 1/4" stamped aluminum cap over the 1/2" Re-bar and insulated the two metals with a plastic insert. Cap is 3" below top of blacktop. Cap is stamped to read: COUNTY REMONUMENTATION, S30, S31, T48N R39W, 1995, P.S. 17610. I established the following bearing trees and a witness monument.

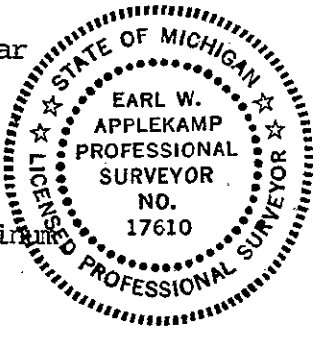

- 6" Scotch Pine      N35°W      54.00 feet - Witness corner a 2 1/2"x30" aluminum
- 8" Maple      N60°E      48.80 feet      pipe with a 3 1/4" stamped cap
- 4" Scotch Pine      S41°E      70.26 feet      S51°W      51.68 feet

Signed by Earl W. Applekamp  
 Surveyor's Michigan License No. 17610

Date July 18, 1995