

LAND CORNER RECORDATION CERTIFICATE
 Filing Requirement of Act 74, Mich. P.A. 1970

For corners in

<u>ONTONAGON</u> (County)	Located In:	Corner Code #
1. Public Land Survey	T <u>48N</u> R <u>40W</u>	<u>A-5</u>
	T <u>48N</u> R <u>41W</u>	<u>M-5</u>
	T ___ R ___	_____
	T ___ R ___	_____
2. Property Controlling in Section	S ___ T ___ R ___	_____
	S ___ T ___ R ___	_____
3. Miscellaneous Property in Sec.	S ___ T ___ R ___	_____
	S ___ T ___ R ___	_____

SURVEY &
 REMONUMENTATION

JAN 11 1998

SECTION


Register of Deeds Stamp & File Number

4. Lot No. _____, Recorded Plat _____
 5. Private Claims _____

Corner common to Sections 7 & 18, T48N R40W &
 12 & 13, T58N R41W.

I, Earl W. Applekamp, in a field survey on June 25, 1998 do hereby state that under requirements of P.A. 74, Michigan P.A. of 1970, the corner points mentioned in lines 1 and 2 above were in conformance with regulations and rules therefore as required in the current manual of survey instructions of the United States Department of the Interior, Bureau of Land Management or by a decree of a Court of Law and/or that the corner points mentioned in lines 3, 4 and 5 above were in conformance with the rules of the Michigan Board of Land Surveyors or by a Decree of a Court of Law; established, re-established, monumented, recovered, found as expressed below:

NOTE: Not more than 2 corners, all in the same town and range, may be recorded on this certificate.

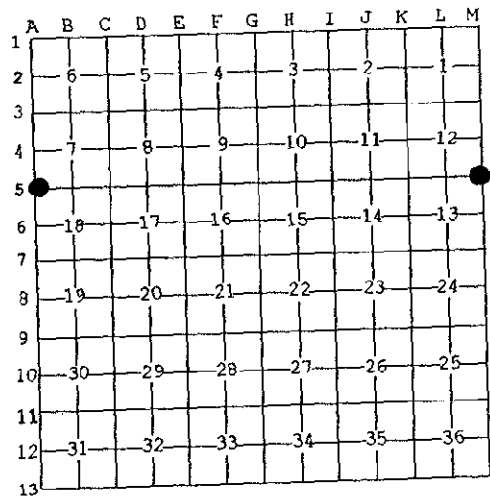

A. Description of original monument and accessories and/or subsequent restoration:

Original corner established by William A. Burt, U.S. Deputy Surveyor, July of 1847. Set Maple Post.

ORIGINAL BEARING TREES:

10" Spruce	S23°E	16.50 feet
6" Y. Birch	N60°W	17.16 feet

PEER GROUP APPROVED
Earl W. Applekamp
 COUNTY SURVEYOR
 7-22-98

B. Description of corner evidence found and/or method applied in restoring or reestablishing corner:


No original evidence was found. Corner position falls in a North-South County Road. At the calculated position there was a well maintained fence running West which divided a woods-field occupied line. I re-established the corner at the intersection of the center-line of the County Road and the fence line. This fence has been maintained since about 1920 as I personally knew the farmer who farmed this land.

Research on file with the Ontonagon County Remonumentation Program Representative.

C. Description of monument for corner and accessories established to perpetuate locating the position of the corner:

At the corner position I set a 5/8"x12" rebar with a 3" stamped cap 6" below top of blacktop and in the center-line of the road. Cap is stamped to read: County Remonumentation, T48N, R40W, R41W, S7, S18, S12, S13, 1998, P.S. 17610. I established a reference monument, a 2 1/2"x30" aluminum pipe with a 3" cap stamped as above. I also established 3 bearing trees.

REF. MON.	S89°-17'-43"E	27.39'	- Nail in 6 1/2" Twin Maple	S67°W	121.05'
Nail in 6" Aspen	S38°E	59.65'	- Nail in 7" Aspen	N39°E	78.70'

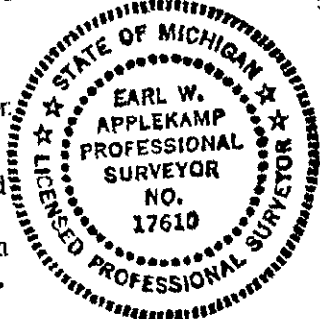

Signed by Earl W. Applekamp
 Surveyor's Michigan License No. 17610

Date June 26, 1998