

**LAND CORNER RECORDATION CERTIFICATE**  
 Filing Requirement of Act 74, Mich. P.A. 1970

For corners in  
ONTONAGON  
 (County)

| Located In: | Corner Code # |
|-------------|---------------|
| T48NR 40W   | A-6           |
| T48NR 41W   | M-6           |
| T R         |               |
| T R         |               |
| S T R       |               |
| S T R       |               |
| S T R       |               |
| S T R       |               |


SURVEY &  
 REMONUMENTATION  
 JAN 11 1998  
 SECTION  
 Register of Deeds Stamp & File Number

- 1. Public Land Survey
- 2. Property Controlling in Section
- 3. Miscellaneous Property in Sec.

4. Lot No. \_\_\_\_\_, Recorded Plat \_\_\_\_\_  
 5. Private Claims \_\_\_\_\_

$\frac{1}{4}$  Corner common to Sections 13 & 18, T48N R40W & R41W.

I, Earl W. Applekamp in a field survey on June 25, 1998 do hereby state that under requirements of P.A. 74, Michigan P.A. of 1970, the corner points mentioned in lines 1 and 2 above were in conformance with regulations and rules therefore as required in the current manual of survey instructions of the United States Department of the Interior, Bureau of Land Management or by a decree of a Court of Law and/or that the corner points mentioned in lines 3, 4 and 5 above were in conformance with the rules of the Michigan Board of Land Surveyors or by a Decree of a Court of Law; established, re-established, monumented, recovered, found as expressed below:

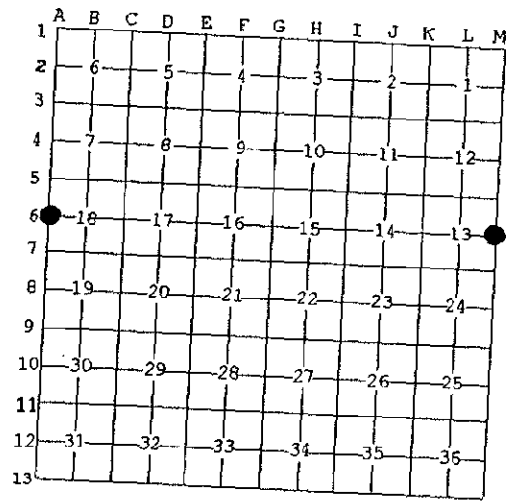

NOTE: Not more than 2 corners, all in the same town and range, may be recorded on this certificate.

A. Description of original monument and accessories and/or subsequent restoration:  
 Original corner established by William A. Burt, U.S. Deputy Surveyor, July 1847. Set Tamarack Post.

ORIGINAL BEARING TREES:  
 10" Spruce S60°E 1.98 feet  
 6" Tamarack S73°W 13.20 feet

PEER GROUP APPROVED  
Earl W. Applekamp  
 COUNTY SURVEYOR

B. Description of corner evidence found and/or method applied in restoring or reestablishing corner:  
 No original evidence was found. Michigan Dept. of Transportation Highway prints, dated 1963 identify the corner as a  $\frac{1}{2}$ " Iron Rod 2640.03 feet North of the Section corner near the center-line of the highway. I did not find the Iron Rod but did find two ties on fence posts which were on the ground. The position identified by MDOT agrees with a woods field line running East. I placed the corner at the position indicated by MDOT. This position is within 6 feet of a split of the Section.

7-22-98

Research on file with the Ontonagon County Remonumentation Program Representative.

C. Description of monument for corner and accessories established to perpetuate locating the position of the corner:  
 At the corner position I set a 5/8"x12" rebar with a 3" stamped cap, 6" below top of gravel in the center-line of a county road. I set two reference monuments, which are 2 1/2"x30" split base aluminum pipe with a 3" cap stamped to read: County Remonumentation, T48N R40W, R41W,  $\frac{1}{4}$ , R.M., S13, S18, 1998, P.S. 17610. I also established two bearing trees

REF. MON. N80°-54'-39"W 36.13' - Nail in 7" Aspen N08°E 261.88'  
 REF. MON. N82°-11'-00"E 41.47' - Nail in 14" Aspen N51°E 171.78'



Signed by Earl W. Applekamp  
 Surveyor's Michigan License No. 17610

Date June 30, 1998