

LAND CORNER RECORDATION CERTIFICATE
 Filing Requirement of Act 74, Mich. P.A. 1970

For corners in

<u>ONTONAGON</u> (County)	Located In:	Corner Code #
1. Public Land Survey	T48N R 40W T48N R 41W	<u>A-7</u> <u>M-7</u>
2. Property Controlling in Section	S ___ T ___ R ___ S ___ T ___ R ___	_____ _____ _____
3. Miscellaneous Property in Sec.	S ___ T ___ R ___ S ___ T ___ R ___	_____ _____ _____

SUTHERLAND
 REMONUMENTATION
 JAN 11 1998
 SECTION

Register of Deeds Stamp & File Number

4. Lot No. _____, Recorded Plat _____
 5. Private Claims _____

Section Corner common to Sections 18 & 19, T48N R40W
 and 13 & 24, T48N R41W.

I, Earl W. Applekamp, in a field survey on June 18, 1998 do hereby state that under requirements of P.A. 74, Michigan P.A. of 1970, the corner points mentioned in lines 1 and 2 above were in conformance with regulations and rules therefore as required in the current manual of survey instructions of the United States Department of the Interior, Bureau of Land Management or by a decree of a Court of Law and /or that the corner points mentioned in lines 3, 4 and 5 above were in conformance with the rules of the Michigan Board of Land Surveyors or by a Decree of a Court of Law; established, re-established, monumented, recovered, found as expressed below:

NOTE: Not more than 2 corners, all in the same town and range, may be recorded on this certificate.

1	A	B	C	D	E	F	G	H	I	J	K	L	M
2	6		5		4		3		2		1		
3													
4	7		8		9		10		11		12		
5													
6	18		17		16		15		14		13		
7													
8	19		20		21		22		23		24		
9													
10	30		29		28		27		26		25		
11													
12	31		32		33		34		35		36		
13													

A. Description of original monument and accessories and/or subsequent restoration:

Original corner established by William A. Burt, U.S. Deputy Surveyor, July 16, 1847. Set Spruce Post.

ORIGINAL BEARING TREES:

8" Aspen S67°E 5.94 feet
 8" Aspen S89°W 15.84 feet

PEER GROUP APPROVED
Earl W. Applekamp
 COUNTY REGISTERED 7-22-98

B. Description of corner evidence found and/or method applied in restoring or reestablishing corner:


No original evidence was found. Corner was re-monumented by M-DOT and is shown on the 1963 Highway drawings of M-28 construction. There is a 3/4" Iron Pin in a monument box at the intersection of the center-line of Michigan Highway M-28 and a North-South County Road. I accepted the location and set two reference monuments as shown below in "C".

Research on file with the Ontonagon County Remonumentation Program Representative.

C. Description of monument for corner and accessories established to perpetuate locating the position of the corner:

At the corner position is a 3/4" Iron Pin in a monument box 1 foot South of the highway center-line. I set two reference monuments which are 2 1/2"x30" split base aluminum pipe with a 3" cap stamped to read: County Remonumentation, T48N R40W, R41W, R.M., 1998, P.S. 17610. I also established two other reference objects.

REF. MON. N41°-00'-47"E 75.91' - Nail in Power Pole N47°W 143.22'
 REF. MON. S42°-26'-53"W 70.66' - Nail in 4" Spruce S44°E 99.96'

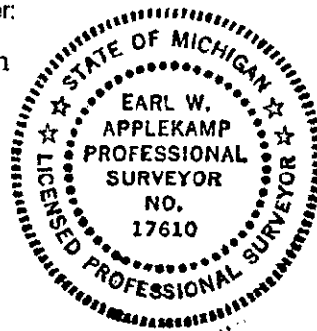

Signed by Earl W. Applekamp
 Surveyor's Michigan License No. 17610

Date July 18, 1998