

**LAND CORNER RECORDATION CERTIFICATE**  
 Filing Requirement of Act 74, Mich. P.A. 1970

For corners in

ONTONAGON  
 (County)

Located In: Corner Code #

- |                                    |                   |            |
|------------------------------------|-------------------|------------|
| 1. Public Land Survey              | T48N R 40W        | <u>A-9</u> |
|                                    | T48N R 41W        | <u>M-9</u> |
|                                    | T ___ R ___       | _____      |
|                                    | T ___ R ___       | _____      |
| 2. Property Controlling in Section | S ___ T ___ R ___ | _____      |
|                                    | S ___ T ___ R ___ | _____      |
| 3. Miscellaneous Property in Sec.  | S ___ T ___ R ___ | _____      |
|                                    | S ___ T ___ R ___ | _____      |

SURVEY  
 REMONUMENTATION

JAN 11 1998

SECTION

Register of Deeds Stamp & File Number

4. Lot No. \_\_\_\_\_, Recorded Plat \_\_\_\_\_  
 5. Private Claims \_\_\_\_\_

Section Corner common to Sections 19 & 30, T48N R40W and Sections 24 & 25, T48N R41W.

I, Earl W. Applekamp, in a field survey on June 17, 1998 do hereby state that under requirements of P.A. 74, Michigan P.A. of 1970, the corner points mentioned in lines 1 and 2 above were in conformance with regulations and rules therefore as required in the current manual of survey instructions of the United States Department of the Interior, Bureau of Land Management or by a decree of a Court of Law and/or that the corner points mentioned in lines 3, 4 and 5 above were in conformance with the rules of the Michigan Board of Land Surveyors or by a Decree of a Court of Law; established, re-established, monumented, recovered, found as expressed below:

NOTE: Not more than 2 corners, all in the same town and range, may be recorded on this certificate.

	A	B	C	D	E	F	G	H	I	J	K	L	M
1													
2	6		5		4		3		2				
3													
4	7		8		9		10		11				12
5													
6	18		17		16		15		14				13
7													
8	19		20		21		22		23				24
9													
10	30		29		28		27		26				25
11													
12	31		32		33		34		35				36
13													

A. Description of original monument and accessories and/or subsequent restoration:

Original corner established by William A. Burt, U.S. Deputy Surveyor, July 16, 1847. Set Cedar Post.

ORIGINAL BEARING TREES:

8" Spruce	N11°E	9.24 feet
8" Cedar	N11°W	9.90 feet

PEER GROUP APPROVAL

Earl W. Applekamp  
 COUNTY REPRESENTATIVE

7-22-98

B. Description of corner evidence found and/or method applied in restoring or reestablishing corner:


No original evidence was found. Corner is marked by a R.R. Spike in the blacktop at the center-line of a blacktop road running East & West and a gravel road running North. This road has been in existence since about 1915. The R.R. Spike has been used to describe several parcels of land in the area. I accepted the R.R. Spike as being the location of the original corner.

Research on file with the Ontonagon County Remonumentation Program Representative.

C. Description of monument for corner and accessories established to perpetuate locating the position of the corner:

At the corner position I replaced the R.R. Spike with a 5/8"x12" rebar with a 3" cap 2" below top of blacktop. The cap is stamped to read: County Remonumentation, T48N R40W, R41W, S19, S30, S24, S25, 1998, P.S. 17610. I established a reference monument, a 2 1/2"x30" aluminum pipe with a 3" cap stamped to read the same as above. I also established 3 bearing trees.

REF. MON. N43°-56'-28"E 66.41' - Nail in 10" Scotch Pine S01°E 51.12'  
 Nail in 11" Scotch Pine S39°E 77.37' - Nail in 7" Aspen N32°W 80.23'

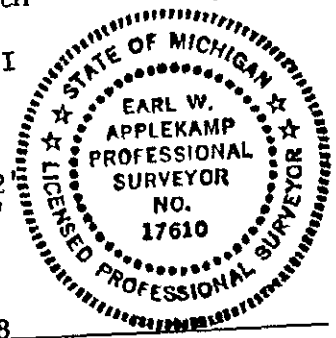

Signed by Earl W. Applekamp  
 Surveyor's Michigan License No. 17610

Date July 20, 1998