


**LAND CORNER RECORDATION CERTIFICATE**  
 Filing Requirement of Act 74, Mich. P.A. 1970

For corners in

<u>ONTONAGON</u> (County)	Located in:	Corner Code #
1. Public Land Survey	T48NR 40W	B-7
	T ___ R ___	_____
	T ___ R ___	_____
	T ___ R ___	_____
2. Property Controlling in Section	S ___ T ___ R ___	_____
	S ___ T ___ R ___	_____
3. Miscellaneous Property in Sec.	S ___ T ___ R ___	_____
	S ___ T ___ R ___	_____

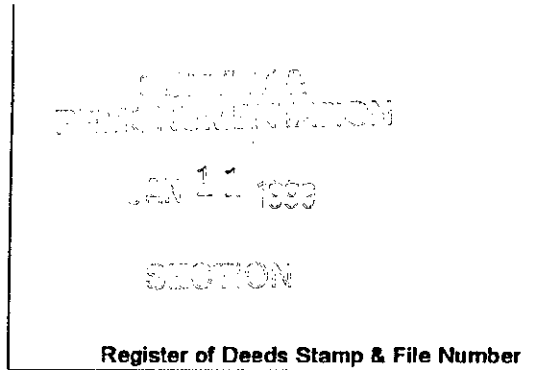

4. Lot No. \_\_\_\_\_, Recorded Plat \_\_\_\_\_  
 5. Private Claims \_\_\_\_\_

¼ Corner common to Sections 18 & 19, T48N R40W.

I, Earl W. Applekamp, in a field survey on July 31, 1998 do hereby state that under requirements of P.A. 74, Michigan P.A. of 1970, the corner points mentioned in lines 1 and 2 above were in conformance with regulations and rules therefore as required in the current manual of survey instructions of the United States Department of the Interior, Bureau of Land Management or by a decree of a Court of Law and /or that the corner points mentioned in lines 3, 4 and 5 above were in conformance with the rules of the Michigan Board of Land Surveyors or by a Decree of a Court of Law; established, re-established, monumented, recovered, found as expressed below:

NOTE: Not more than 2 corners, all in the same town and range, may be recorded on this certificate.

	A	B	C	D	E	F	G	H	I	J	K	L	M
1													
2		6		5		4		3		2		1	
3													
4		7		8		9		10		11		12	
5													
6		18		17		16		15		14		13	
7		●											
8		19		20		21		22		23		24	
9													
10		30		29		28		27		26		25	
11													
12		31		32		33		34		35		36	
13													

A. Description of original monument and accessories and/or subsequent restoration:

Original corner established by Wells Burt, U.S. Deputy Surveyor, May 24, 1851. Set Wood Post.

ORIGINAL BEARING TREES:

10" Y. Birch	S40°W	2.64 feet
9" Maple	N10°W	10.56 feet

**PERR GROUP APPROVED**  
*Earl W. Applekamp*  
 COUNTY REGISTER  
 8-19-98

B. Description of corner evidence found and/or method applied in restoring or reestablishing corner:


No original evidence remains. Corner position falls in an abandoned Township Road. No other evidence was found. The Section to the North was cleared in 1908 and farming took place until about 1985. I re-established the corner by proportionate measure between opposite Section Corners, East and West and in the center-line of the abandoned Township Road.

Research on file with the Ontonagon County Remonumentation Program Representative

C. Description of monument for corner and accessories established to perpetuate locating the position of the corner:

At the corner position I set a 2½"X30" split base aluminum pipe with a 3" cap stamped to read: County Remonumentation, T48N R40W, ¼, S18, S19, 1998, P.S. 17610. I established four bearing objects.

Nail in 14" Black Ash	S53°W	70.20'	-	Nail in Fence Post	N35°E	15.38'
Nail in 4½" Aspen	S31°E	40.58'	-	6' Steel Sign Post	East	0.80'

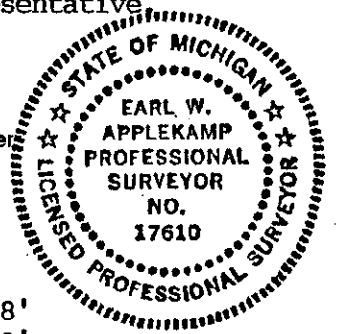

Signed by Earl W. Applekamp  
 Surveyor's Michigan License No. 17610

Date August 17, 1998