

LAND CORNER RECORDATION CERTIFICATE
Filing Requirement of Act 74, Mich. P.A. 1970

For corners in

ONTONAGON
(County)

Located in:

Corner Code #

1. Public Land Survey

T48N R 40W

B-9

T R

T R

T R

2. Property Controlling in Section

S T R

S T R

3. Miscellaneous Property in Sec.

S T R

S T R

4. Lot No. Recorded Plat
5. Private Claims

1/4 Corner common to Sections 19 & 30, T48N R40W.

I, Earl W. Applekamp, in a field survey on June 18, 1998 do hereby state that under requirements of P.A. 74, Michigan P.A. of 1970, the corner points mentioned in lines 1 and 2 above were in conformance with regulations and rules therefore as required in the current manual of survey instructions of the United States Department of the Interior, Bureau of Land Management or by a decree of a Court of Law and /or that the corner points mentioned in lines 3, 4 and 5 above were in conformance with the rules of the Michigan Board of Land Surveyors or by a Decree of a Court of Law; established, re-established, monumented, recovered, found as expressed below.

NOTE: Not more than 2 corners, all in the same town and range, may be recorded on this certificate.

A. Description of original monument and accessories and/or subsequent restoration:

Original corner established by Wells Burt, U.S. Deputy Surveyor, June 6, 1851. Set Wood Post.

ORIGINAL BEARING TREES:

7" Spruce N80°W 11.22 feet
16" Tamarack N03°E 15.84 feet

PEER GROUP APPROVAL
Earl W. Applekamp
COUNTY CLERK 7-22-98

B. Description of corner evidence found and/or method applied in restoring or reestablishing corner:

No original evidence was found. Corner is in an East-West road, (Old M-28) which has been in existence since about 1915. Corner was re-established by single proportionate measure and on line between opposite section corners East & West. This puts the corner in the center-line of the road.

Research on file with the Ontonagon County Remonumentation Program Representative.

C. Description of monument for corner and accessories established to perpetuate locating the position of the corner:


At the corner position I set a 5/8"X12" rebar with a 3" stamped cap 2 1/2" below top of blacktop. Cap is stamped to read: County Remonumentation, T48N R40W, 1/4, S19, S30, 1998, P.S. 17610. I established a Reference Monument, a 2 1/2"X30" split base aluminum pipe with a 3" cap stamped to read same as above. I also established 3 other bearing objects.

REF. MON. N01°-04'-37"W 34.66' - Nail in Power Pole S66°E 80.28'
Nail in Power Pole S86°E 425.33' - Nail in Power Pole S84°W 276.81'



Signed by Earl W. Applekamp
Surveyor's Michigan License No. 17610

Date July 20, 1998

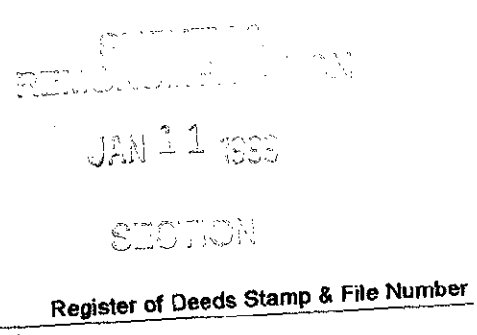

Grid table with columns A-M and rows 1-13. A dot is marked at row 9, column B.