


**LAND CORNER RECORDATION CERTIFICATE**  
 Filing Requirement of Act 74, Mich. P.A. 1970

For corners in

<u>ONTONAGON</u> (County)	Located In:	Corner Code #
1. Public Land Survey	T48N R 40W	E-5
	T R	
	T R	
	T R	
2. Property Controlling in Section	S T R	
	S T R	
3. Miscellaneous Property in Sec.	S T R	
	S T R	

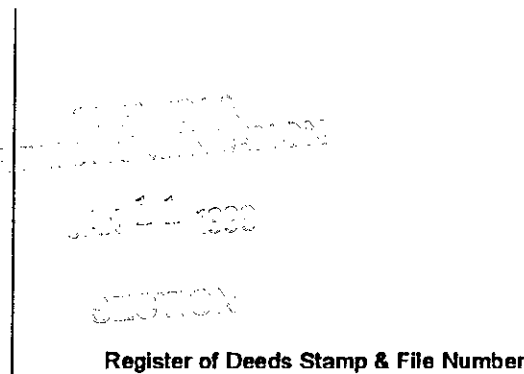


4. Lot No. \_\_\_\_\_, Recorded Plat \_\_\_\_\_  
 5. Private Claims \_\_\_\_\_

Corner common to Sections 8, 9, 16 & 17, T48N R40W.

I, Earl W. Applekamp, in a field survey on August 07 19 98 do hereby state that under requirements of P.A. 74, Michigan P.A. of 1970, the corner points mentioned in lines 1 and 2 above were in conformance with regulations and rules therefore as required in the current manual of survey instructions of the United States Department of the Interior, Bureau of Land Management or by a decree of a Court of Law and/or that the corner points mentioned in lines 3, 4 and 5 above were in conformance with the rules of the Michigan Board of Land Surveyors or by a Decree of a Court of Law; established, re-established, monumented, recovered, found as expressed below:

NOTE: Not more than 2 corners, all in the same town and range, may be recorded on this certificate.

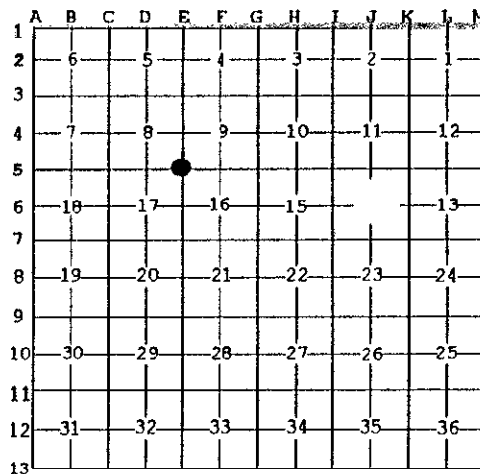

A. Description of original monument and accessories and/or subsequent restoration:

Original corner established by Wells Burt, U.S. Deputy Surveyor, June 2, 1851. Set Wood Post.

ORIGINAL BEARING TREES:

16" Hemlock N10°W 9.24 feet  
 8" Sugar S25°W 19.80 feet

No record of any subsequent restoration.

PEER GROUP APPROVAL  
*Earl W. Applekamp*  
 COUNTY SURVEYOR  
 8-19-98

B. Description of corner evidence found and/or method applied in restoring or reestablishing corner:

No original evidence was found. Corner position is in a gravel county road. I found a 1 3/4" pipe 10" below and in the center-line of the gravel road. This position agreed with a GLO creek call to the North. I found the remains of an old fence running West. According to a local resident who has lived in the area for 60 years, the fence was built in the early 1900's. I accepted the position of the 1 3/4" pipe and monumented the corner as shown below.

Research on file with the Ontonagon County Remonumentation Program Representative

C. Description of monument for corner and accessories established to perpetuate locating the position of the corner:

At the corner position I set a 5/8"x12" rebar with a 3" stamped cap into the pipe. Cap is 6" below top of gravel. I established a reference monument which is a 2 1/2"x30" aluminum pipe with a 3" cap stamped to read: County Remonumentation, T48N R40W, S8, S9, S16, S17, R.M., 1998, P.S. 17610. I also established 3 other bearing objects.



REF. MON. N89°-56'-47"W 34.13' - Nail in 10" Aspen S41°E 106.82'  
 Nail in P. Pole N64°E 27.23' - Nail in 10" Spruce S57°W 57.87'

Signed by Earl W. Applekamp  
 Surveyor's Michigan License No. 17610

Date August 10, 1998