

DEC 16 1996

COMMISSION

JUDITH D. ROEHN
 Ontonagon County
 LC 4/54 JEM Fee: 9.00
 Page 1 of 1

LAND CORNER RECORDATION CERTIFICATE
 Filing Requirement of Act 74, Mich. P.A. 1970

For corners in

ONTONAGON (County)	Located In:	Corner Code #
1. Public Land Survey	T48N R 40W	G-11
	T ___ R ___	_____
	T ___ R ___	_____
	T ___ R ___	_____
2. Property Controlling in Section	S ___ T ___ R ___	_____
	S ___ T ___ R ___	_____
3. Miscellaneous Property in Sec.	S ___ T ___ R ___	_____
	S ___ T ___ R ___	_____

Register of Deeds Stamp & File Number

4. Lot No. _____, Recorded Plat _____
 5. Private Claims _____

Section Corner common to Sections 27, 28, 33 & 34, T48N R40W.

I, Earl W. Applekamp, in a field survey on April 24, 1996 do hereby state that under requirements of P.A. 74, Michigan P.A. of 1970, the corner points mentioned in lines 1 and 2 above were in conformance with regulations and rules therefore as required in the current manual of survey instructions of the United States Department of the Interior, Bureau of Land Management or by a decree of a Court of Law and for that the corner points mentioned in lines 3, 4 and 5 above were in conformance with the rules of the Michigan Board of Land Surveyors or by a Decree of a Court of Law; established, re-established, monumented, recovered, found as expressed below:

NOTE: Not more than 2 corners, all in the same town and range, may be recorded on this certificate.

1	A	B	C	D	E	F	G	H	I	J	K	L	M
2		6		5		4		3		2		1	
3													
4		7		8		9		10		11		12	
5													
6		18		17		16		15		14		13	
7													
8		19		20		21		22		23		24	
9													
10		30		29		28		27		26		25	
11													
12		31		32		33		34		35		36	
13													

A. Description of original monument and accessories and/or subsequent restoration:

Original corner established by J. Wells Burt, U.S. Deputy Surveyor, May 1851. Set Wood Post.

ORIGINAL BEARING TREES:

Cedar 12" S24°W 7 links
 Cedar 14" N25°E 25 links

PEER GROUP APPROVED
Earl W. Applekamp 5-07-96
 COUNTY REPRESENTATIVE

B. Description of corner evidence found and/or method applied in restoring or reestablishing corner:


No original evidence was found except stream calls. At the corner position I found a 1" pipe 6" below top of gravel road. A fence runs East for 3/4 mile from this marker. Distances to corners North, South & West are in agreement with the original field notes. I accepted the pipe as the true location for the corner as being the only logical position for the corner.

Research on file with the Ontonagon County Remonumentation Representative.

C. Description of monument for corner and accessories established to perpetuate locating the position of the corner:

At the corner position I placed a 5/8"x24" Re-Bar into the pipe and placed a 3 1/4" cap 3" below the gravel surface, stamped to read: County Remonumentation, S27, S28, S33, S34, T48N R40W, 1996, P.S. 17610. I established one reference monument, a 2 1/2"x30" aluminum pipe with a 3 1/4" stamped cap and three bearing trees.

REF. MON. S83°-53'-02"E 31.40' 6" Aspen S09°-56'-43"W 166.51'
 13" Basswood S35°-33'-44"E 54.06' 7" Aspen N40°-22'-47"E 43.94'

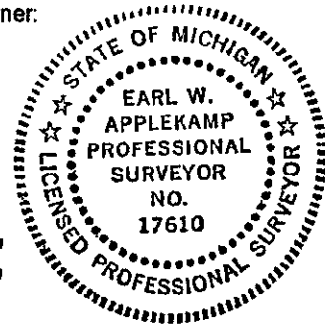

Signed by Earl W. Applekamp
 Surveyor's Michigan License No. 17610

Date April 29, 1996