

DEC 16 1996

COMMISSION

**LAND CORNER RECORDATION CERTIFICATE**  
 Filing Requirement of Act 74, Mich. P.A. 1970

JUDITH D. ROEHM  
 Ontonagon County  
 LC 4/ 90 JEM Fee: 9.00  
 Page 1 of 1

For corners in

<u>ONTONAGON</u> (County)	Located In:	Corner Code #
1. Public Land Survey	T48N R 40W	G-12
	T ___ R ___	_____
	T ___ R ___	_____
	T ___ R ___	_____
2. Property Controlling in Section	S ___ T ___ R ___	_____
	S ___ T ___ R ___	_____
3. Miscellaneous Property in Sec.	S ___ T ___ R ___	_____
	S ___ T ___ R ___	_____

Register of Deeds Stamp & File Number

4. Lot No. \_\_\_\_\_, Recorded Plat \_\_\_\_\_  
 5. Private Claims \_\_\_\_\_

1/4 Corner common to Sections 33 & 34, T48N R40W.

I, Earl W. Applekamp, in a field survey on May 15, 1996 do hereby state that under requirements of P.A. 74, Michigan P.A. of 1970, the corner points mentioned in lines 1 and 2 above were in conformance with regulations and rules therefore as required in the current manual of survey instructions of the United States Department of the Interior, Bureau of Land Management or by a decree of a Court of Law and/or that the corner points mentioned in lines 3, 4 and 5 above were in conformance with the rules of the Michigan Board of Land Surveyors or by a Decree of a Court of Law; established, re-established, monumented, recovered, found as expressed below:

NOTE: Not more than 2 corners, all in the same town and range, may be recorded on this certificate.

1	A	B	C	D	E	F	G	H	I	J	K	L	M
2		6		5		4		3		2		1	
3													
4		7		8		9		10		11		12	
5													
6		18		17		16		15		14		13	
7													
8		19		20		21		22		23		24	
9													
10		30		29		28		27		26		25	
11													
12		31		32		33		34		35		36	
13													

A. Description of original monument and accessories and/or subsequent restoration:

Original corner established by Wells Burt, U.S. Deputy Surveyor, May 30, 1851. Set Wood Post.

ORIGINAL BEARING TREES:

Cedar 12" S64°E :26-links  
 Y. Birch 6" N63°W 20 links

B. Description of corner evidence found and/or method applied in restoring or reestablishing corner:

No original evidence was found. Corner was re-established by single proportionate measurement on line between opposite Section corners North and South.


PEER GROUP APPROVED  
*Earl W. Applekamp*  
 COUNTY REPRESENTATIVE  
 07-08-96

Research on file with the Ontonagon County Remonumentation Representative.

C. Description of monument for corner and accessories established to perpetuate locating the position of the corner:

At the corner position I set a 5/8"x24" rebar with a 3 1/4" cap stamped 6" below top of a gravel County road. I established one reference monument, a 2 1/4"x30" aluminum pipe with a 3 1/4" cap stamped to read: County Remonumentation, 1/4, T48N R40W, S33, S34, 1996, P.S. 17610. I also established 3 bearing trees.

REF. MON. S89°-50'-00"E 31.59' - 5" Aspen N57°-52'-20"E 153.41'  
 5" Aspen N31°-24'-03"E 155.65' - 6" Aspen S37°-35'-21"E 241.59'

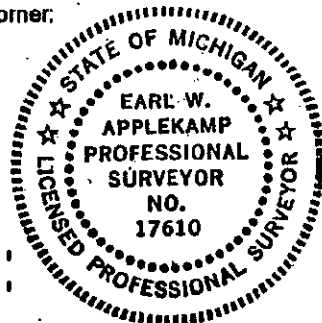

Signed by Earl W. Applekamp  
 Surveyor's Michigan License No. 17610

Date June 6, 1996