

**SURVEY & REMONUMENTATION**

MAY 05 1997

COMMISSION

JUDITH D. ROEHN  
 Ontonagon County  
 LC 4/ 72 JEM Feet 9.00  
 06/10/96 15:42  
 Page 1 of 1

**LAND CORNER RECORDATION CERTIFICATE**  
 Filing Requirement of Act 74, Mich. P.A. 1970

For corners in

<u>ONTONAGON</u> (County)	Located In:	Corner Code #
1. Public Land Survey	T <u>48N</u> R <u>40W</u>	<u>H-11</u>
	T <u>   </u> R <u>   </u>	<u>   </u>
	T <u>   </u> R <u>   </u>	<u>   </u>
	T <u>   </u> R <u>   </u>	<u>   </u>
2. Property Controlling in Section	S <u>   </u> T <u>   </u> R <u>   </u>	<u>   </u>
	S <u>   </u> T <u>   </u> R <u>   </u>	<u>   </u>
3. Miscellaneous Property in Sec.	S <u>   </u> T <u>   </u> R <u>   </u>	<u>   </u>
	S <u>   </u> T <u>   </u> R <u>   </u>	<u>   </u>

Register of Deeds Stamp & File Number

4. Lot No. \_\_\_\_\_, Recorded Plat \_\_\_\_\_  
 5. Private Claims \_\_\_\_\_

1/4 Corner common to Sections 27 & 34, T48N R40W.

I, Earl W. Applekamp, in a field survey on May 17, 1996 do hereby state that under requirements of P.A. 74, Michigan P.A. of 1970, the corner points mentioned in lines 1 and 2 above were in conformance with regulations and rules therefore as required in the current manual of survey instructions of the United States Department of the Interior, Bureau of Land Management or by a decree of a Court of Law and/or that the corner points mentioned in lines 3, 4 and 5 above were in conformance with the rules of the Michigan Board of Land Surveyors or by a Decree of a Court of Law; established, re-established, monumented, recovered, found as expressed below:

NOTE: Not more than 2 corners, all in the same town and range, may be recorded on this certificate.

	A	B	C	D	E	F	G	H	I	J	K	L	M
1													
2	6		5		4		3		2		1		
3													
4	7		8		9		10		11		12		
5													
6	18		17		16		15		14		13		
7													
8	19		20		21		22		23		24		
9													
10	30		29		28		27		26		25		
11													
12	31		32		33		34		35		36		
13													

A. Description of original monument and accessories and/or subsequent restoration:

Original corner established by Wells Burt, U.S. Deputy Surveyor, May 30, 1851. Set Wood Post.

ORIGINAL BEARING TREES:

Spruce 10" N22°W 27 links  
 W. Pine 10" N58°E 10 links

PEER GROUP APPROVED  
*Earl W. Applekamp*  
 COUNTY SURVEYOR

06-06-96

B. Description of corner evidence found and/or method applied in restoring or reestablishing corner:


No original evidence was found. The only present evidence is a fence line running East and West on the apparent Section line. Original calls to swamps East & West are in conformance with the fence location which adds validity to the fence being on the Section line. The corner will be re-established by proportionate measurement between opposite section corners but North & South on the existing fence line.

Research on file with the Ontonagon County Remonumentation Representative.

C. Description of monument for corner and accessories established to perpetuate locating the position of the corner:

At the corner location I established a 2 1/2"x30" aluminum pipe with a 3 1/2" cap stamped to read: County Remonumentation, 1/4, T48N R40W, S27, S34, 1996, P.S. 17610. I established the following trees and reference objects.

3" Aspen N47°-48'-58"W 133.96' - 4" Spruce N25°-42'-02"E 107.94'  
 15" Oak N14°-40'-09"W 190.43' - Steel Sign Post West 1.21'

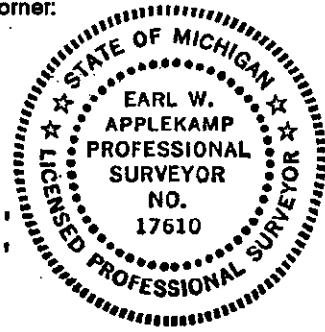

Signed by Earl W. Applekamp  
 Surveyor's Michigan License No. 17610

Date June 3, 1996