

**SURVEY & REMONUMENTATION**

DEC 16 1996

**COMMISSION**

**LAND CORNER RECORDATION CERTIFICATE**  
Filing Requirement of Act 74, Mich. P.A. 1970

JUDITH D. ROEHM 07/11/96  
Ontonagon County 08:45  
LC 4/94 JEM Fee: 9.00  
Page 1 of 1

For corners in

ONTONAGON (County)	Located In:	Corner Code #
1. Public Land Survey	T48N R40W	I-7
	T___ R___	_____
	T___ R___	_____
	T___ R___	_____
2. Property Controlling In Section	S___ T___ R___	_____
	S___ T___ R___	_____
3. Miscellaneous Property in Sec.	S___ T___ R___	_____
	S___ T___ R___	_____

Register of Deeds Stamp & File Number

4. Lot No. \_\_\_\_\_, Recorded Plat \_\_\_\_\_  
5. Private Claims \_\_\_\_\_

Section Corner common to Sections 14, 15, 22 & 23, T48N R40W.

I, Earl W. Applekamp, in a field survey on June 13, 1996 do hereby state that under requirements of P.A. 74, Michigan P.A. of 1970, the corner points mentioned in lines 1 and 2 above were in conformance with regulations and rules therefore as required in the current manual of survey instructions of the United States Department of the Interior, Bureau of Land Management or by a decree of a Court of Law and/or that the corner points mentioned in lines 3, 4 and 5 above were in conformance with the rules of the Michigan Board of Land Surveyors or by a Decree of a Court of Law; established, re-established, monumented, recovered, found as expressed below:

NOTE: Not more than 2 corners, all in the same town and range, may be recorded on this certificate.

	A	B	C	D	E	F	G	H	I	J	K	L	M
1													
2	6		5		4		3		2		1		
3													
4	7		8		9		10		11		12		
5													
6	18		17		16		15		14		13		
7													
8	19		20		21		22		23		24		
9													
10	30		29		28		27		26		25		
11													
12	31		32		33		34		35		36		
13													

A. Description of original monument and accessories and/or subsequent restoration:

Original corner established by Wells Burt, U.S. Deputy Surveyor, May 24, 1851. Set Wood Post.

ORIGINAL BEARING TREES:

Tamarack 10" S27.5°W 30 links  
Tamarack 8" N62°W 39 links

PEER GROUP APPROVED  
Earl W. Applekamp  
COUNTY REPRESENTATIVE  
07-08-96

B. Description of corner evidence found and/or method applied in restoring or reestablishing corner:


No original evidence was found. At the calculated position East & West there is an old fence running North & South. This fence is 60 plus years old. Corner was re-established on this fence line for departure. Latitude was determined on a line between opposite quarter section corners which are on gravel roads. The location is in conformance with the original call to end of swamp to the West, which if moved a few feet North would change this call by several hundred feet. the corner is set at the only logical position.

Research on file with the Ontonagon County Remonumentation Program Representative.

C. Description of monument for corner and accessories established to perpetuate locating the position of the corner:

At the corner position I set 3/4"x11" aluminum rod with a 3/4" cap stamped to read: County Remonumentation, T48N R40W, S14, S15, S22, S23, 1996, P.S. 17610. This corner is set 524 feet West of the left bank of the South Branch Ontonagon River. I established five bearing objects.

11" Tamarack N83°-09'-41"W 58.82' - P. line N00°-33'-35"W 91.08'  
4" Tamarack S02°-13'-21"E 27.23' - Steel Sign Post East 0.84'  
11" W. Pine N23°-12'-35"E 59.41'

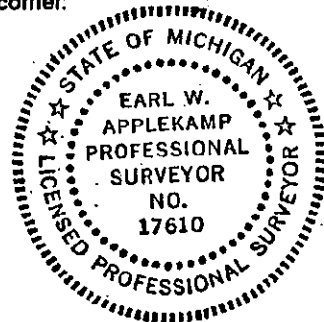

Signed by Earl W. Applekamp  
Surveyor's Michigan License No. 17610

Date June 27, 1996