

DEC 16 1996

COMMISSION

JUDITH D. ROEHM
Ontonagon County
LC 4/ 49 JEM Fee: 9.00
Page 1 of 1

LAND CORNER RECORDATION CERTIFICATE
Filing Requirement of Act 74, Mich. P.A. 1970

For corners in

<u>ONTONAGON</u> (County)	Located In:	Corner Code #
1. Public Land Survey	<u>T48N R 40W</u>	<u>T-9</u>
	T <u> </u> R <u> </u>	<u> </u>
	T <u> </u> R <u> </u>	<u> </u>
	T <u> </u> R <u> </u>	<u> </u>
2. Property Controlling in Section	S <u> </u> T <u> </u> R <u> </u>	<u> </u>
	S <u> </u> T <u> </u> R <u> </u>	<u> </u>
3. Miscellaneous Property in Sec.	S <u> </u> T <u> </u> R <u> </u>	<u> </u>
	S <u> </u> T <u> </u> R <u> </u>	<u> </u>

Register of Deeds Stamp & File Number

4. Lot No. _____, Recorded Plat _____
5. Private Claims _____

Section Corner common to Sections 22, 23, 26, & 27, T48N R40W.

I, Earl W. Applekamp, in a field survey on April 23, 1996 do hereby state that under requirements of P.A. 74, Michigan P.A. of 1970, the corner points mentioned in lines 1 and 2 above were in conformance with regulations and rules therefore as required in the current manual of survey instructions of the United States Department of the Interior, Bureau of Land Management or by a decree of a Court of Law and/or that the corner points mentioned in lines 3, 4 and 5 above were in conformance with the rules of the Michigan Board of Land Surveyors or by a Decree of a Court of Law; established, re-established, monumented, recovered, found as expressed below:

A	B	C	D	E	F	G	H	I	J	K	L	M
1												
2	6		5		4		3		2		1	
3												
4	7		8		9		10		11		12	
5												
6	18		17		16		15		14		13	
7												
8	19		20		21		22		23		24	
9												
10	30		29		28		27		26		25	
11												
12	31		32		33		34		35		36	
13												

NOTE: Not more than 2 corners, all in the same town and range, may be recorded on this certificate.

A. Description of original monument and accessories and/or subsequent restoration:

Original corner established by J. Wells Burt, U.S. Deputy Surveyor, May 1851. Set Wood Post.

ORIGINAL BEARING TREES:

Tamarack 10" S78°W 14 links
Tamarack 12" N63°E 16 links

PEER GROUP APPROVED

Earl W. Applekamp 507-96
COUNTY REPRESENTATIVE


B. Description of corner evidence found and/or method applied in restoring or reestablishing corner:

At the corner position there is a 1" iron pin in a monument box near the centerline of Highway M-28. This location has been used since the town of Ewen was platted in 1890. This iron pin has been used for numerous surveys in the past 40 years. It is in agreement with the several plats in the town of Ewen.

Research on file with the Ontonagon County Remonumentation Representative.

C. Description of monument for corner and accessories established to perpetuate locating the position of the corner:

I accepted the 1" iron pin in a monument box in Highway M-28. I established two reference monuments which are 3/4"X20" aluminum rod with 3 1/4" stamped cap set 4" below ground. I also established two other reference objects. Reference monument caps are stamped to read: County Remonumentation, S22, S23, S26, S27, T48N R40W, R.M., 1996, P.S. 17610.

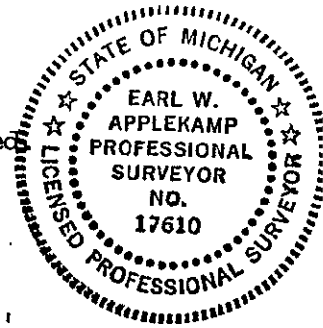

REF. MON. S72°-29'-02"W 96.74' P. Pole N08°-27'-09"E 176.22'
REF. MON. N30°-59'-16"E 52.52' P. Pole S14°-28'-05"E 26.38'

Signed by Earl W. Applekamp
Surveyor's Michigan License No. 17610

Date April 30, 1996