

SURVEY & REMONUMENTATION

DEC 16 1996


COMMISSION

LAND CORNER RECORDATION CERTIFICATE
Filing Requirement of Act 74, Mich. P.A. 1970

JUDITH D. ROEHM
Ontonagon County
LC 4/ 96 JEM Fee: 9.00
Page 1 of 1

For corners in

<u>ONTONAGON</u> (County)	Located In:	Corner Code #
1. Public Land Survey	T <u>48</u> NR <u>40</u> W	<u>J-11</u>
	T ___ R ___	_____
	T ___ R ___	_____
	T ___ R ___	_____
2. Property Controlling in Section	S ___ T ___ R ___	_____
	S ___ T ___ R ___	_____
3. Miscellaneous Property in Sec.	S ___ T ___ R ___	_____
	S ___ T ___ R ___	_____

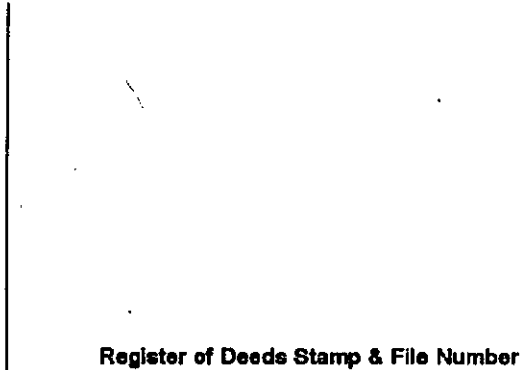

4. Lot No. _____, Recorded Plat _____
5. Private Claims _____

1/2 Corner common to Sections 26 & 35, T48N R40W.

I, Earl W. Applekamp, in a field survey on June 18, 1996 do hereby state that under requirements of P.A. 74, Michigan P.A. of 1970, the corner points mentioned in lines 1 and 2 above were in conformance with regulations and rules therefore as required in the current manual of survey instructions of the United States Department of the Interior, Bureau of Land Management or by a decree of a Court of Law and /or that the corner points mentioned in lines 3, 4 and 5 above were in conformance with the rules of the Michigan Board of Land Surveyors or by a Decree of a Court of Law, established, re-established, monumented, recovered, found as expressed below:

NOTE: Not more than 2 corners, all in the same town and range, may be recorded on this certificate.

1	A	B	C	D	E	F	G	H	I	J	K	L	M
2		6		5		4		3		2		1	
3													
4		7		8		9		10		11		12	
5													
6		18		17		16		15		14		13	
7													
8		19		20		21		22		23		24	
9													
10		30		29		28		27		26		25	
11										●			
12		31		32		33		34		35		36	
13													

A. Description of original monument and accessories and/or subsequent restoration:

Original corner established by Wells Burt, U.S. Deputy Surveyor, May 28, 1851. Set Wood Post.

ORIGINAL BEARING TREES:

Cedar 12" S30°E .18 links
Cedar 12" S52°W 17 links

B. Description of corner evidence found and/or method applied in restoring or reestablishing corner:

No original evidence was found. Corner was re-established by single proportionate measurement on line between opposite section corners.


Research on file with the Ontonagon County Remonumentation Program Representative.

PEER GROUP APPROVED
Earl W. Applekamp
COUNTY REPRESENTATIVE
07-08-96

C. Description of monument for corner and accessories established to perpetuate locating the position of the corner:

At the corner position I set a 2 1/2" X 30" aluminum pipe with a 3 1/4" cap stamped to read: County Remonumentation, 1/4, T48N R40W, S26, S35, 1996, P.S. 17610. I established four bearing objects.

REA P. Pole S88°-02'-07"W 99.18' - Top & S. edge of a 6" I-Beam
8" Aspen S18°-59'-33"W 36.32' Guard Rail Post N24°-25'-11"E 32.87'
Steel Sign Post South 0.70'

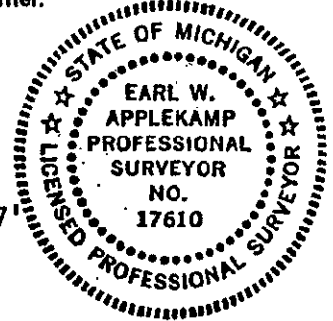

Signed by Earl W. Applekamp
Surveyor's Michigan License No. 17610

Date June 27, 1996