

**SURVEY & REMONUMENTATION**

DEC 16 1996


**COMMISSION**

JUDITH D. ROEHM  
 Ontonagon County  
 LC 4/ 60 JEM Fee: 9.00  
 Page 1 of 1

**LAND CORNER RECORDATION CERTIFICATE**  
 Filing Requirement of Act.74, Mich. P.A. 1970

For corners in

<u>ONTONAGON</u> (County)	Located In:	Corner Code #
1. Public Land Survey	T <u>48NR 40W</u>	<u>K-7</u>
	T <u>    </u> R <u>    </u>	<u>    </u>
	T <u>    </u> R <u>    </u>	<u>    </u>
	T <u>    </u> R <u>    </u>	<u>    </u>
2. Property Controlling in Section	S <u>    </u> T <u>    </u> R <u>    </u>	<u>    </u>
	S <u>    </u> T <u>    </u> R <u>    </u>	<u>    </u>
3. Miscellaneous Property in Sec.	S <u>    </u> T <u>    </u> R <u>    </u>	<u>    </u>
	S <u>    </u> T <u>    </u> R <u>    </u>	<u>    </u>

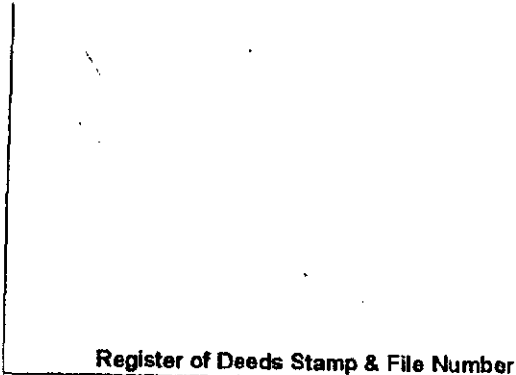

4. Lot No. \_\_\_\_\_, Recorded Plat \_\_\_\_\_  
 5. Private Claims \_\_\_\_\_

Section Corner common to Sections 13, 14, 23 & 24, T48N R40W.

I, Earl W. Applekamp in a field survey on April 23, 1996 do hereby state that under requirements of P.A. 74, Michigan P.A. of 1970, the corner points mentioned in lines 1 and 2 above were in conformance with regulations and rules therefore as required in the current manual of survey instructions of the United States Department of the Interior, Bureau of Land Management or by a decree of a Court of Law and /or that the corner points mentioned in lines 3, 4 and 5 above were in conformance with the rules of the Michigan Board of Land Surveyors or by a Decree of a Court of Law; established, re-established, monumented, recovered, found as expressed below:

NOTE: Not more than 2 corners, all in the same town and range, may be recorded on this certificate.

	A	B	C	D	E	F	G	H	I	J	K	L	M
1													
2	6		5		4		3		2		1		
3													
4	7		8		9		10		11		12		
5													
6	10		17		16		15		14		13		
7													
8	19		20		21		22		23		24		
9													
10	30		29		28		27		26		25		
11													
12	31		32		33		34		35		36		
13													

A. Description of original monument and accessories and/or subsequent restoration:

Original corner established by J. Wells Burt, U.S. Deputy Surveyor in May 1851. Set Wood Post.

ORIGINAL BEARING TREES:

Yellow Pine 10" N25°W 5 links  
 Yellow Pine 6" S47°E 18 links

PEER GROUP APPROVED  
Earl W. Applekamp 05-07-96  
 COUNTY REPRESENTATIVE

B. Description of corner evidence found and/or method applied in restoring or reestablishing corner:

At the corner I found a 1" drill steel 2" below top of blacktop. This location is at the intersection of two County Roads. The location is consistent with the original calls. The drill steel is identified in several surveys. I accepted the drill steel as being the true location of the corner.

Research on file with the Ontonagon County Remonumentation Representative.

C. Description of monument for corner and accessories established to perpetuate locating the position of the corner:

At the corner position I left the 1" drill steel for the corner location. I established a reference monument, a 2 1/2" X 30" aluminum pipe with a 3 1/4" cap stamped to read: County Remonumentation, S13, S14, S23, S24, T48N R40W, R.M., 1996, P.S. 17610. I established three other reference objects.

REF. MON. S49°-40'-06"E 53.93' REA P. Pole N10°-46'-15"W 170.31'  
 REA P. Pole S45°-40'-17"W 44.99' REA P. Pole S79°-03'-31"E 170.09'  
 REF. MON. N42°-23'-33"W 46.65'



Signed by Earl W. Applekamp  
 Surveyor's Michigan License No. 17610

Date April 30, 1996