

DEC 16 1996

COMMISSION

JUDITH D. ROEHM 07/11/96  
 Ontonagon County 08:49  
 LC 4/102 JEM Fee: 9.00  
 Page 1 of 1

LAND CORNER RECORDATION CERTIFICATE  
 Filing Requirement of Act 74, Mich. P.A. 1970

For corners in

| ONTONAGON<br>(County)                 | Located In:    | Corner Code # |
|---------------------------------------|----------------|---------------|
| 1. Public Land Survey                 | T48N R40W      | I-7           |
|                                       | T___ R___      | _____         |
|                                       | T___ R___      | _____         |
|                                       | T___ R___      | _____         |
| 2. Property Controlling<br>In Section | S___ T___ R___ | _____         |
|                                       | S___ T___ R___ | _____         |
| 3. Miscellaneous<br>Property in Sec.  | S___ T___ R___ | _____         |
|                                       | S___ T___ R___ | _____         |

Register of Deeds Stamp & File Number

4. Lot No. \_\_\_\_\_, Recorded Plat \_\_\_\_\_  
 5. Private Claims \_\_\_\_\_

$\frac{1}{4}$  Corner common to Section 13 & 24, T48N R40W.

I, Earl W. Applekamp, in a field survey on June 21, 1996 do hereby state that under requirements of P.A. 74, Michigan P.A. of 1970, the corner points mentioned in lines 1 and 2 above were in conformance with regulations and rules therefore as required in the current manual of survey instructions of the United States Department of the Interior, Bureau of Land Management or by a decree of a Court of Law and/or that the corner points mentioned in lines 3, 4 and 5 above were in conformance with the rules of the Michigan Board of Land Surveyors or by a Decree of a Court of Law; established, re-established, monumented, recovered, found as expressed below:

NOTE: Not more than 2 corners, all in the same town and range, may be recorded on this certificate.

|    | A  | B | C  | D | E  | F | G  | H | I  | J | K  | L | M |
|----|----|---|----|---|----|---|----|---|----|---|----|---|---|
| 1  |    |   |    |   |    |   |    |   |    |   |    |   |   |
| 2  | 6  |   | 5  |   | 4  |   | 3  |   | 2  |   | 1  |   |   |
| 3  |    |   |    |   |    |   |    |   |    |   |    |   |   |
| 4  | 7  |   | 8  |   | 9  |   | 10 |   | 11 |   | 12 |   |   |
| 5  |    |   |    |   |    |   |    |   |    |   |    |   |   |
| 6  | 18 |   | 17 |   | 16 |   | 15 |   | 14 |   | 13 |   |   |
| 7  |    |   |    |   |    |   |    |   |    |   |    |   |   |
| 8  | 19 |   | 20 |   | 21 |   | 22 |   | 23 |   | 24 |   |   |
| 9  |    |   |    |   |    |   |    |   |    |   |    |   |   |
| 10 | 30 |   | 29 |   | 28 |   | 27 |   | 26 |   | 25 |   |   |
| 11 |    |   |    |   |    |   |    |   |    |   |    |   |   |
| 12 | 31 |   | 32 |   | 33 |   | 34 |   | 35 |   | 36 |   |   |
| 13 |    |   |    |   |    |   |    |   |    |   |    |   |   |

A. Description of original monument and accessories and/or subsequent restoration:

Original corner established by Wells Burt, U.S. Deputy Surveyor, May 25, 1851. Set Wood Post.

ORIGINAL BEARING TREES:

W. Pine 10" N14°W 15 links  
 W. Birch 12" S43°W 24 links

B. Description of corner evidence found and/or method applied in restoring or reestablishing corner:

No original evidence was found. Corner was re-established by single proportionate measurement and on line between opposite section Corners.


Research on file with the Ontonagon County Remonumentation Program Representative.

PEER GROUP APPROVED  
*Earl W. Applekamp*  
 COUNTY REPRESENTATIVE  
 07-08-96

C. Description of monument for corner and accessories established to perpetuate locating the position of the corner:

At the corner position I set a 5/8"x24" rebar with a 3 1/4" stamped cap 5" below the top of gravel in the centerline of a county road. Cap is stamped to read: County Remonumentation,  $\frac{1}{4}$ , T48N R40W, S13, S24, 1996, P.S. 17610. I established one reference monument, a 2 1/2"x30" aluminum pipe with a 3 1/4" stamped cap. I also established three other reference objects.

REF. MON. N00°-43'-42"E 31.17' - 3" Aspen N45°-52'-13"W 49.06'  
 REA P. Pole S43°-33'-30"E 39.88' - 8" Spruce N21°-11'-32"E 55.77'

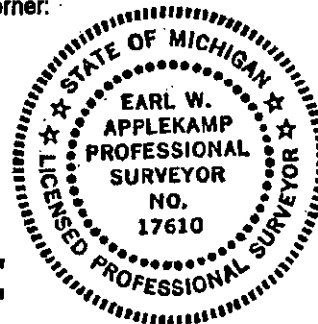

Signed by Earl W. Applekamp  
 Surveyor's Michigan License No. 17610

Date June 26, 1996