

**SURVEY & REMONUMENTATION**

JUDITH D. ROEHM  
 Ontonagon County  
 LC 4/ 56 JEM Fee: 9.00  
 05/09/96  
 14:26  
 Page 1 of 1

DEC 16 1996

**LAND CORNER RECORDATION CERTIFICATE**  
 Filing Requirement of Act 74, Mich. P.A. 1970

For corners in **COMMISSION**

<u>ONTONAGON</u> (County)	Located in:	Corner Code #
1. Public Land Survey	T 48NR 39W	A-9
	T 48NR 40W	M-9 ✓
	T ___ R ___	___
	T ___ R ___	___
	T ___ R ___	___
2. Property Controlling in Section	S ___ T ___ R ___	___
	S ___ T ___ R ___	___
3. Miscellaneous Property in Sec.	S ___ T ___ R ___	___
	S ___ T ___ R ___	___

Register of Deeds Stamp & File Number

4. Lot No. \_\_\_\_\_, Recorded Plat \_\_\_\_\_  
 5. Private Claims \_\_\_\_\_

Section Corner common to Sections 19 & 30, T48N R39W and Sections 24 & 25, T48N R40W.

I, Earl W. Applekamp, in a field survey on April 18, 1996 do hereby state that under requirements of P.A. 74, Michigan P.A. of 1970, the corner points mentioned in lines 1 and 2 above were in conformance with regulations and rules therefore as required in the current manual of survey instructions of the United States Department of the Interior, Bureau of Land Management or by a decree of a Court of Law and /or that the corner points mentioned in lines 3, 4 and 5 above were in conformance with the rules of the Michigan Board of Land Surveyors or by a Decree of a Court of Law, established, re-established, monumented, recovered, found as expressed below:

NOTE: Not more than 2 corners, all in the same town and range, may be recorded on this certificate.

1	A	B	C	D	E	F	G	H	I	J	K	L	M
2		6		5		4		3		2		1	
3													
4		7		8		9		10		11		12	
5													
6		18		17		16		15		14		13	
7													
8		19		20		21		22		23		24	
9													
10		30		29		28		27		26		25	
11													
12		31		32		33		34		35		36	
13													

A. Description of original monument and accessories and/or subsequent restoration:

Corner established by Artemas Curtis, U.S. Deputy Surveyor, April 1851. Set Maple Post.

ORIGINAL BEARING TREES:

Cedar 8" S74°E 7 links  
 Spruce 16" N72°W 21 links

PEER GROUP APPROVED

Earl W. Applekamp  
 COUNTY REPRESENTATIVE  
 05-07-96

B. Description of corner evidence found and/or method applied in restoring or reestablishing corner:


At the apparent corner position I found a 1½" iron rod in a box in the blacktop of Michigan Highway M-28. This corner has been in since at least 1963. The location is in conformance with the original GLO notes. I accepted the location as being the correct position.

Research is on file with the County Remonumentation Representative.

C. Description of monument for corner and accessories established to perpetuate locating the position of the corner:

At the corner position is a 1½" iron rod in a monument box. I set two reference monuments which are 2½"X30" aluminum pipe with a 3¼" cap stamped to read: County Remonumentation, RM, S19, S24, S25, S30, T48N-R39W, R40W, 1996, P.S. 17610. In addition to the reference monuments I established two other reference objects.

REF. MON. N02°-24'-41"E 54.34' P. Pole S45°-07'-46"E 82.59'  
 REF. MON. S40°-02'-35"W 87.63' 7" Oak N47°-00'-13"E 90.13'

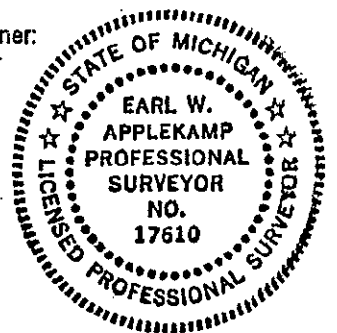

Signed by Earl W. Applekamp  
 Surveyor's Michigan License No. 17610

Date April 29, 1996