

APR 29 1996

COMMISSION

**LAND CORNER RECORDATION CERTIFICATE
Filing Requirement of Act 74, Mich. P.A. 1970**

JUDITH D. ROEHM
Ontonagon County
LC 3/305 JEM Fee: 9.00
Page 1 of 1

For corners in ONTONAGON (County) Located In: _____ Corner Code # _____

1. Public Land Survey	T 48 R 41	<u>A-2</u>
	T 48 R 42	M-2
	T _____ R _____	_____
	T _____ R _____	_____
2. Property Controlling in Section	S _____ T _____ R _____	_____
	S _____ T _____ R _____	_____
3. Miscellaneous Property in Section	S _____ T _____ R _____	_____
	S _____ T _____ R _____	_____

Register of Deeds Stamp & File Number

4. Lot No. _____, Recorded Plat _____
5. Private Claims _____

$\frac{1}{4}$ Corner common to Section 1 & 6, T48N R41, 42W

I, Earl W. Applekamp, in a field survey on June 27, 1995, do hereby certify that under requirements of P.A. 74, Michigan P.A. of 1970, the corner points mentioned in lines 1 and 2 above were in conformance with regulations and rules therefore as required in the current manual of survey instructions of the United States Department of the Interior, Bureau of Land Management or by a decree of a Court of Law and/or that the corner points mentioned in lines 3, 4 and 5 above were in conformance with the rules of the Michigan Board of Professional Surveyors or by a Decree of a Court of Law; established, re-established, monumented, re-monumented, recovered, found as expressed below:

NOTE: Not more than 4 corners, all in the same town and range, may be recorded on this certificate.

A	B	C	D	E	F	G	H	I	J	K	L	M
6		5		4		3		2				
7												
8	7	8	9	10	11	12						
9												
10	18	17	16	15	14	13						
11												
12	19	20	21	22	23	24						
13												
14	30	29	28	27	26	25						
15												
16	31	32	33	34	35	36						
17												

A. Description of original monument and accessories and/or subsequent restoration:

Original corner established by William A. Burt, U.S. Deputy Surveyor, July 1857. Set Cedar Post.


BEARING TREES:

Hemlock 11" N30°E 27 Links (17.82 feet)
White Pine 36" N46°W 20 Links (13.20 feet)

B. Description of corner evidence found and/or method applied in restoring or reestablishing corner:

Corner location is on a gravel road. The area East of the road is a field. A well maintained fence runs East from this location with dwelling on the North & South. The location is consistent with the original field notes. An iron pipe was found 30 feet West of the corner location. No object was found in the roadway. I set a monument in the road and a Witness monument at the corner location as described in "C" below. This corner is one of 29 corners in 6 Sections remonumented under the County Remonumentation Program. Research on file with the Ontonagon County Remonumentation Program Representative.

PEER GROUP APPROVED
Earl W. Applekamp 8-08-95
COUNTY REPRESENTATIVE

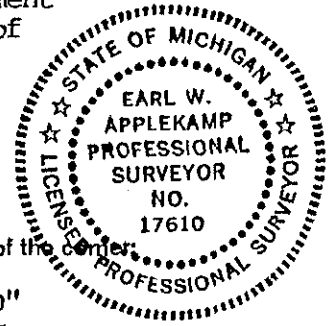

C. Description of monument for corner and accessories established to perpetuate locating the position of the corner:

At the corner location I set a 3/4"x 18" aluminum rod with a 3 1/4" cap 10" below the gravel road. Cap is stamped to read: COUNTY REMONUMENTATION, $\frac{1}{4}$, S1, S6, T48N R41-42W, 1995, P.S. 17610. I established the following bearing trees and reference objects:

7" Aspen	N64°W	73.24 feet	REA Power Pole W/transformer N17°E, 132.17 feet
4" Spruce	S64°W	46.33 feet	2 1/2"x30" Monument with 3 1/4" Cap W.C. West 26.55 feet

Signed by Earl W. Applekamp Date June 27, 1995
Surveyor's Michigan License No. 17610