

SURVEY & REMONUMENTATION

APR 29 1996

JUDITH D. ROEHM
 Ontonagon County
 LC 3/303 JEM Fee: 9.00
 08/09/95
 14:27
 Page 1 of 1

COMMISSION LAND CORNER RECORDATION CERTIFICATE
Filing Requirement of Act 74, Mich. P.A. 1970


For corners in	Located In:	Corner Code #
<u>ONTONAGON</u> (County)		
1. Public Land Survey	T <u>48</u> R <u>41</u>	<u>A-4</u>
	T <u>48</u> R <u>42</u>	<u>M-4</u>
	T _____ R _____	_____
	T _____ R _____	_____
2. Property Controlling in Section	S _____ T _____ R _____	_____
	S _____ T _____ R _____	_____
3. Miscellaneous Property in Section	S _____ T _____ R _____	_____
	S _____ T _____ R _____	_____

Register of Deeds Stamp & File Number

4. Lot No. _____, Recorded Plat _____
 5. Private Claims _____

$\frac{1}{4}$ Section corner common to Sections 7 & 12, T48N R41W and R42W

I, Earl W. Applekamp, in a field survey on June 27, 19 95, do hereby certify that under requirements of P.A. 74, Michigan P.A. of 1970, the corner points mentioned in lines 1 and 2 above were in conformance with regulations and rules therefore as required in the current manual of survey instructions of the United States Department of the Interior, Bureau of Land Management or by a decree of a Court of Law and/or that the corner points mentioned in lines 3, 4 and 5 above were in conformance with the rules of the Michigan Board of Professional Surveyors or by a Decree of a Court of Law; established, re-established, monumented, re-monumented, recovered, found as expressed below:

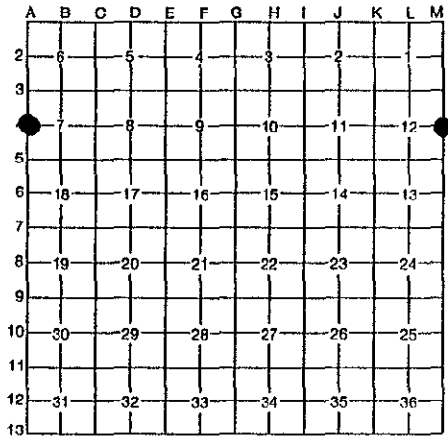

NOTE: Not more than 4 corners, all in the same town and range, may be recorded on this certificate.

A. Description of original monument and accessories and/or subsequent restoration:

Original corner established by William A. Burt, U.S. Deputy Surveyor, July 1857. Set Sugar Post.

BEARING TREES:

- Sugar Maple 8" S50°E 9 Links (5.94 feet)
- Sugar Maple 16" N65°W 30 Links (19.80 feet)

B. Description of corner evidence found and/or method applied in restoring or reestablishing corner:

No original evidence of the corner was found. Corner location is at the intersection of a N & S gravel road and a gravel road running East. This location is consistent with the total distance between opposite Section corners N & S. Corner was set by single proportionate measurement. I set a monument and witness corner described in "C" below. This corner is one of 29 corners in 6 Sections remonumented under the County Remonumentation Program. Research is on file with the Ontonagon County Remonumentation Program Representative.

BEER GROUP APPROVED
Earl W. Applekamp 8-08-95
COUNTY REPRESENTATIVE

C. Description of monument for corner and accessories established to perpetuate locating the position of the corner:

At the corner position I set a 2 $\frac{1}{4}$ "x30" aluminum pipe with a 3 $\frac{1}{4}$ " cap 4" below top of gravel. The cap is stamped to read: COUNTY REMONUMENTATION, $\frac{1}{4}$, S7, S12, T48N R41W & 42W, 1995, P.S. 17610. I established the following bearing trees and reference objects.

- 5" Maple N53°W 61.40 feet
- 9" Maple N43°E 104.61 feet
- 8" Maple S61°E 63.33 feet
- 2 $\frac{1}{2}$ "x30" long pipe W/cap, W.C. West 32.70 feet



Signed by Earl W. Applekamp Date July 12, 1995
 Surveyor's Michigan License No. 17610