

SURVEY & REMONUMENTATION

APR 29 1996

COMMISSION

JUDITH D. ROEHM
 Ontonagon County
 LC 3/289 JEM Fee: 9.00
 08/09/95
 13:39
 Page 1 of 1

LAND CORNER RECORDATION CERTIFICATE
 Filing Requirement of Act 74, Mich. P.A. 1970

For corners in ONTONAGON
 (County)

Located In:

Corner Code #

1. Public Land Survey	T 48	R 41	A-5
	T 48	R 42	M-5
	T	R	
	T	R	
2. Property Controlling in Section	S	T	R
	S	T	R
3. Miscellaneous Property in Section	S	T	R
	S	T	R

Register of Deeds Stamp & File Number

4. Lot No. _____, Recorded Plat _____
 5. Private Claims _____

A	B	C	D	E	F	G	H	I	J	K	L	M
2	6	5	4	3	2							
3												
4	7	8	9	10	11	12						
5												
6	18	17	16	15	14	13						
7												
8	19	20	21	22	23	24						
9												
10	30	29	28	27	26	25						
11												
12	31	32	33	34	35	36						
13												

Section Corner common to Sections 7 & 18, T48N R41W and Sections 12 & 13, T48N R42W

I, Earl W. Applekamp, in a field survey on May 23, 1995, do hereby certify that under requirements of P.A. 74, Michigan P.A. of 1970, the corner points mentioned in lines 1 and 2 above were in conformance with regulations and rules therefore as required in the current manual of survey instructions of the United States Department of the Interior, Bureau of Land Management or by a decree of a Court of Law and/or that the corner points mentioned in lines 3, 4 and 5 above were in conformance with the rules of the Michigan Board of Professional Surveyors or by a Decree of a Court of Law; established, re-established, monumented, re-monumented, recovered, found as expressed below:

NOTE: Not more than 4 corners, all in the same town and range, may be recorded on this certificate.

A. Description of original monument and accessories and/or subsequent restoration:

Corner established by John Burt, Deputy Surveyor, August 1848, Set Hemlock Post.

Original Bearing Trees:

Spruce 8" N11°E 27 Links
 Cedar 16" S85°W 15 Links


B. Description of corner evidence found and/or method applied in restoring or reestablishing corner:

A survey by E.W. Applekamp in 1971 indicates a 1 1/2" Iron Pipe was at the corner. Ties were on the survey but no pipe was found. The location was in the centerline of a road running East and a fence line running West. It was in the West lane of a road running North & South. I accepted the position and set a monument as described below. This corner was one of the corners remonumented in a Block of 6 Sections in which all original corners were re-established.

Research on file with the County Remonumentation Program Representative.

PEER GROUP APPROVED

Earl W. Applekamp 8-08-95
 COUNTY REPRESENTATIVE

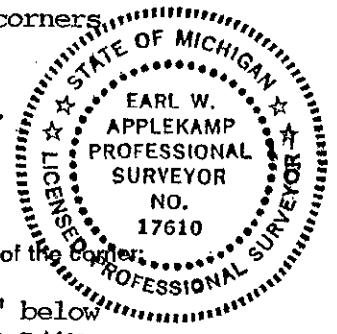

C. Description of monument for corner and accessories established to perpetuate locating the position of the corner:

At the corner position I set a 3/4"x18" aluminum rod with a 3 1/4" cap 8" below top of gravel stamped to read: COUNTY REMONUMENTATION, S7, S18, T48N R41W, S12, S13, T48N R42W, 1995, P.S. 17610. I established the following bearing trees and witness monument.

6" Maple N70°W 53.94 Feet - 7" Basswood S58°E 69.38 Feet
 3" Maple N50°E 60.92 Feet - Witness Corner West 24.67 Feet

Signed by Earl W. Applekamp Date May 23, 1995
 Surveyor's Michigan License No. 17610