

**LAND CORNER RECORDATION CERTIFICATE**  
 Filing Requirement of Act 74, Mich. P.A. 1970

For corners in

ONTONAGON (County)	Located In:	Corner Code #
1. Public Land Survey	T48NR 41W	B-7
	T R	
	T R	
	T R	
2. Property Controlling in Section	S T R	
	S T R	
3. Miscellaneous Property in Sec.	S T R	
	S T R	


AEMC  
 OCT 3 9 1997  
 COMMISSION  
 Register of Deeds Stamp & File Number

4. Lot No. \_\_\_\_\_, Recorded Plat \_\_\_\_\_  
 5. Private Claims \_\_\_\_\_

$\frac{1}{2}$  Corner common to Sections 18 & 19, T48N R41W.

I, Earl W. Applekamp, in a field survey on Sept. 05, 1997 do hereby state that under requirements of P.A. 74, Michigan P.A. of 1970, the corner points mentioned in lines 1 and 2 above were in conformance with regulations and rules therefore as required in the current manual of survey instructions of the United States Department of the Interior, Bureau of Land Management or by a decree of a Court of Law and/or that the corner points mentioned in lines 3, 4 and 5 above were in conformance with the rules of the Michigan Board of Land Surveyors or by a Decree of a Court of Law; established, re-established, monumented, recovered, found as expressed below:

NOTE: Not more than 2 corners, all in the same town and range, may be recorded on this certificate.

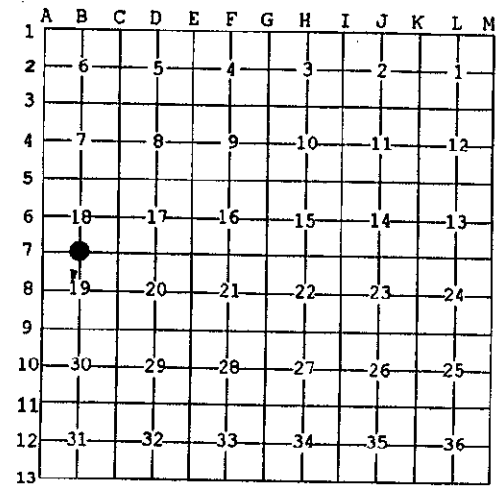

A. Description of original monument and accessories and/or subsequent restoration:

Original corner established by Wells Burt, U.S. Deputy Surveyor, June 10, 1851. Set Wood Post.

ORIGINAL BEARING TREES:

- 14" Spruce S46°E 10.56 feet
- 12" Elm N56°W 13.20 feet

PEER GROUP APPROVED  
*Earl W. Applekamp*  
 COUNTY REPRESENTATIVE  
 9-17-97

B. Description of corner evidence found and/or method applied in restoring or reestablishing corner:

No original evidence was found. Extensive farming has been performed South of the corner since 1920. A well maintained fence runs South and West from the apparent corner and an old fence runs East. There is a woods and field line running East. A calculated position using single proportionate measure and line between opposite section corners falls about 25' N45°E from the fence corner and occupied property by three parties. Corner was re-established at the fence corner as being the only logical position for the corner.

Research on file with the Ontonagon County Remonumentation Program Representative.

C. Description of monument for corner and accessories established to perpetuate locating the position of the corner:

At the corner position I set a 2 1/2"X30" aluminum pipe with a 3" cap stamped to read: County Remonumentation, T48N R41W,  $\frac{1}{4}$ , S18, S19, 1997, P.S. 17610. I established 3 bearing trees and a reference object.

- 6" Aspen N70°W 58.55' - 6 1/2" Aspen N69°E 135.59'
- 6" Spruce N20°E 97.39' - Steel Sign Post, due South 0.85'



Signed by Earl W. Applekamp  
 Surveyor's Michigan License No. 17610

Date September 16, 1997