


APR 29 1996

COMMISSION

JUDITH D. ROEHM
Ontonagon County
LC 3/294 JEM Fee: 9.00
08/09/95
13:54
Page 1 of 1

LAND CORNER RECORDATION CERTIFICATE
Filing Requirement of Act 74, Mich. P.A. 1970

For corners in	<u>ONTONAGON</u>	Located In:	Corner Code #
	(County)		
1. Public Land Survey	T <u>48</u> R <u>41</u>		<u>C-4</u>
	T _____ R _____		_____
	T _____ R _____		_____
	T _____ R _____		_____
2. Property Controlling in Section	S _____ T _____ R _____		_____
	S _____ T _____ R _____		_____
3. Miscellaneous Property in Section	S _____ T _____ R _____		_____
	S _____ T _____ R _____		_____

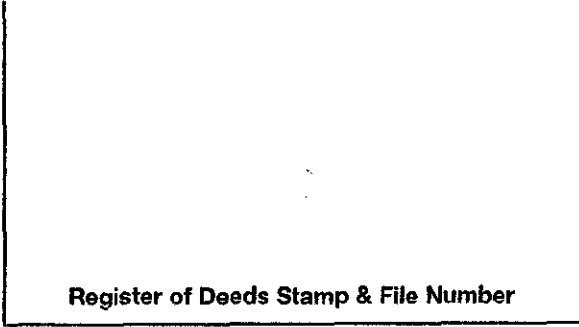

- 4. Lot No. _____, Recorded Plat _____
- 5. Private Claims _____

$\frac{1}{4}$ Section Corner common to 7 & 8, T48N R41W

I, Earl W. Applekamp, in a field survey on May 23, 19 95 do hereby certify that under requirements of P.A. 74, Michigan P.A. of 1970, the corner points mentioned in lines 1 and 2 above were in conformance with regulations and rules therefore as required in the current manual of survey instructions of the United States Department of the Interior, Bureau of Land Management or by a decree of a Court of Law and/or that the corner points mentioned in lines 3, 4 and 5 above were in conformance with the rules of the Michigan Board of Professional Surveyors or by a Decree of a Court of Law; established, re-established, monumented, re-monumented, recovered, found as expressed below:

A	B	C	D	E	F	G	H	I	J	K	L	M
2	6	5	4	3	2							
3												
4	7	8	9	10	11	12						
5												
6	18	17	16	15	14	13						
7												
8	19	20	21	22	23	24						
9												
10	30	29	28	27	26	25						
11												
12	31	32	33	34	35	36						
13												

NOTE: Not more than 4 corners, all in the same town and range, may be recorded on this certificate.

A. Description of original monument and accessories and/or subsequent restoration:

Corner established by Wills Birt, U.S. Deputy Surveyor, June 1851, Corner was a 6" Spruce.

Original Bearing Trees:


W. Pine 10"	East	2 Links	(1.32 Feet)
Spruce 12"	S68°E	19 Links	(12.54 Feet)

B. Description of corner evidence found and/or method applied in restoring or reestablishing corner:

At the corner position I found a 1" drill steel on the North edge of an abandoned R.R. grade. This drill steel was used for several surveys in the area since 1963. The position is consistent with the field notes of the original Government survey. I replaced the drill steel with a monument described below. This corner was one of the corners re-monumented in a Block of 6 Sections in which all original corners were re-established.

Research on file with the County Remonumentation Program Representative.

PEER GROUP APPROVED
Earl W. Applekamp 8-08-95
COUNTY REPRESENTATIVE

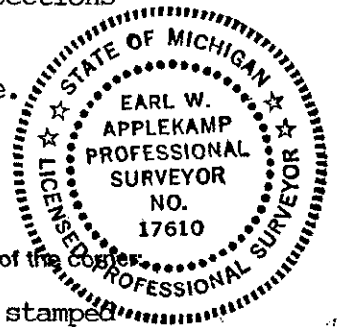

C. Description of monument for corner and accessories established to perpetuate locating the position of the corner:

At the corner position I set a 2 1/4"x30" aluminum pipe with a 3/4" cap stamped to read: COUNTY REMONUMENTATION, 1/4, S7, S8, T48N R41W, 1995, P.S. 17610. The monument is 4" below grade. I established the following witnesses.

5" Spruce	N33°W	48.53 Feet	-	P. Pole	S05°E	240.00 Feet
SW Corner Town Hall	N56°E	221.80 Feet	-	Steel Sign Post	South	17.50 Feet

Signed by *Earl W. Applekamp* Date June 10, 1995
 Surveyor's Michigan License No. 17610