

LAND CORNER RECORDATION CERTIFICATE
 Filing Requirement of Act 74, Mich. P.A. 1970

For corners in

<u>ONTONAGON</u> (County)	Located In:	Corner Code #
1. Public Land Survey	T 48NR 41W	C-9
	T ___ R ___	_____
	T ___ R ___	_____
	T ___ R ___	_____
2. Property Controlling in Section	S ___ T ___ R ___	_____
	S ___ T ___ R ___	_____
3. Miscellaneous Property in Sec.	S ___ T ___ R ___	_____
	S ___ T ___ R ___	_____

Surveyor
 REMONUMENTATION

OCT 30 1997

COMMISSION


Register of Deeds Stamp & File Number

4. Lot No. _____, Recorded Plat _____
 5. Private Claims _____

Section Corner common to Sections 19, 20, 29 & 30, T48N R41W.

I, Earl W. Applekamp, in a field survey on July 23, 1997 do hereby state that under requirements of P.A. 74, Michigan P.A. of 1970, the corner points mentioned in lines 1 and 2 above were in conformance with regulations and rules therefore as required in the current manual of survey instructions of the United States Department of the Interior, Bureau of Land Management or by a decree of a Court of Law and/or that the corner points mentioned in lines 3, 4 and 5 above were in conformance with the rules of the Michigan Board of Land Surveyors or by a Decree of a Court of Law; established, re-established, monumented, recovered, found as expressed below:

NOTE: Not more than 2 corners, all in the same town and range, may be recorded on this certificate.

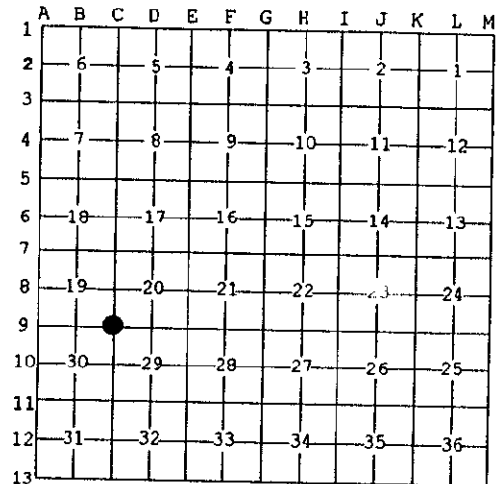

A. Description of original monument and accessories and/or subsequent restoration:

Original corner established by Wells Burt, U.S. Deputy Surveyor, June 12, 1851. Set Wood Post.

ORIGINAL BEARING TREES:

16" Maple N28°E 7.92 feet
 12" Cedar S40°W 11.22 feet

B. Description of corner evidence found and/or method applied in restoring or reestablishing corner:

No original evidence was found. A 6" spike was found at the apparent corner position. No record of where it came from. The position is at a 90° bend in Old M-28. This road runs East along the Section line for 8 miles and North 2½ Miles. A dirt road runs West and South from this location. Corner was re-established at the intersection of these roads as the only logical position for the corner.

Research on file with the Ontonagon County Remonumentation Program Representative.

PEER GROUP REPRESENTATIVE
Earl W. Applekamp
 COUNTY REPRESENTATIVE
 8-13-97

C. Description of monument for corner and accessories established to perpetuate locating the position of the corner:

At the corner position I set a 5/8"X12" rebar with a 3" stamped cap 8" below the road surface. I established a reference monument, a 2½"X30" aluminum pipe with a 3" cap stamped to read: County Remonumentation, T48N R41W, R.M., S19, S20, S29, S30, 1997, P.S. 17610. I also established three other bearing objects.

REF. MON. S42°-59'-07"W 42.95' ~ 10" Aspen N52°W 78.94'
 P. Pole N66°-33'-27"E 87.22' ~ 7" Aspen S52°E 75.07'



Signed by Earl W. Applekamp
 Surveyor's Michigan License No. 17610

Date July 29, 1997