

LAND CORNER RECORDATION CERTIFICATE
Filing Requirement of Act 74, Mich. P.A. 1970

For corners in

ONTONAGON

(County)

Located in:

Corner Code #

1. Public Land Survey

T48N R 41W

C-11

T R

T R

T R

2. Property Controlling
in Section

S T R

S T R

3. Miscellaneous
Property in Sec.

S T R

S T R

4. Lot No. _____, Recorded Plat _____

5. Private Claims _____

Section Corner common to Sections 29, 30, 31 & 32, T48N R41W.

I, Earl W. Applekamp, in a field survey on Aug. 19, 1999 do hereby state that under requirements of P.A. 74, Michigan P.A. of 1970, the corner points mentioned in lines 1 and 2 above were in conformance with regulations and rules therefore as required in the current manual of survey instructions of the United States Department of the Interior, Bureau of Land Management or by a decree of a Court of Law and/or that the corner points mentioned in lines 3, 4 and 5 above were in conformance with the rules of the Michigan Board of Land Surveyors or by a Decree of a Court of Law; established, re-established, monumented, recovered, found as expressed below:

NOTE: Not more than 2 corners, all in the same town and range, may be recorded on this certificate.

A. Description of original monument and accessories and/or subsequent restoration:

Original corner established by Wells Burt, U.S. Deputy Surveyor, June 12, 1851. Set Wood Post.

ORIGINAL BEARING TREES:

12" Y. Birch S48°E 3.96 feet
16" Cedar S76°W 9.24 feet

B. Description of corner evidence found and/or method applied in restoring or reestablishing corner:

No original evidence was found. A dirt road runs North and South at this location. The road has been there for the past 50 years but no residences are near this corner. I found a yellow paint line across the road and a 4"x4" yellow tag identifying the approximate corner. This was set by Champion Inc. Foresters. A blue paint line runs West from this location. I accepted the evidence found as the location for the corner. This position is in conformance with the original field notes.

Research on file with the Ontonagon County Remonumentation Program Representative.

C. Description of monument for corner and accessories established to perpetuate locating the position of the corner:

At the corner position I set a 5/8"x12" Rebar, with a 3" cap 6" below the center-line of the dirt road. Cap is stamped to read: County Remonumentation, T48N, R41W, S29, S30, S31, S32, 1999, P.S. 17610. I set a reference monument, a 2 1/2"x30" Split base aluminum pipe with a cap stamped as above, except adding R.M. I established three bearing trees.

REF. MON. S78°E 26.31' - Nail in 12" Twin Tamarack N63°W 34.86'
Nail in 5" Spruce N50°E 41.88' - Nail in 5" Spruce S86°W 43.05'

SURVEY &
REMONUMENTATION

MAR 28 2000

SECTION


Register of Deeds Stamp & File Number

A	B	C	D	E	F	G	H	I	J	K	L	M
1												
2	6	5	4	3	2	1						
3												
4	7	8	9	10	11	12						
5												
6	10	17	16	15	14	13						
7												
8	19	20	21	22	23	24						
9												
10	30	29	28	27	26	25						
11												
12	31	32	33	34	35	36						
13												

DEED GROUP REPRESENTATIVE

Earl W. Applekamp
COUNTY REPRESENTATIVE

8-24-99

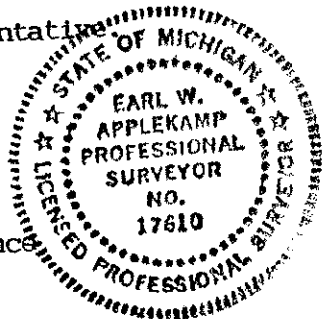

Signed by Earl W. Applekamp
Surveyor's Michigan License No. 17610

Date August 21, 1999