

APR 29 1996

COMMISSION

JUDITH D. ROEHM
Ontonagon County
LC 3/295 JEM Fee: 9.00
08/09/95
13:57
Page 1 of 1

LAND CORNER RECORDATION CERTIFICATE
Filing Requirement of Act 74, Mich. P.A. 1970

For corners in
ONTONAGON
(County)

Located In:

Corner Code #

1. Public Land Survey	T	<u>48</u>	R	<u>41</u>	<u>D-3</u>
	T		R		
	T		R		
	T		R		
2. Property Controlling in Section	S		T		
	S		T		
3. Miscellaneous Property in Section	S		T		
	S		T		


Register of Deeds Stamp & File Number

4. Lot No. _____, Recorded Plat _____
5. Private Claims _____

$\frac{1}{4}$ Corner common to Sections 5 & 8, T48N R41W

I, Earl W. Applekamp, in a field survey on June 01, 1995, do hereby certify that under requirements of P.A. 74, Michigan P.A. of 1970, the corner points mentioned in lines 1 and 2 above were in conformance with regulations and rules therefore as required in the current manual of survey instructions of the United States Department of the Interior, Bureau of Land Management or by a decree of a Court of Law and/or that the corner points mentioned in lines 3, 4 and 5 above were in conformance with the rules of the Michigan Board of Professional Surveyors or by a Decree of a Court of Law; established, re-established, monumented, re-monumented, recovered, found as expressed below:

NOTE: Not more than 4 corners, all in the same town and range, may be recorded on this certificate.

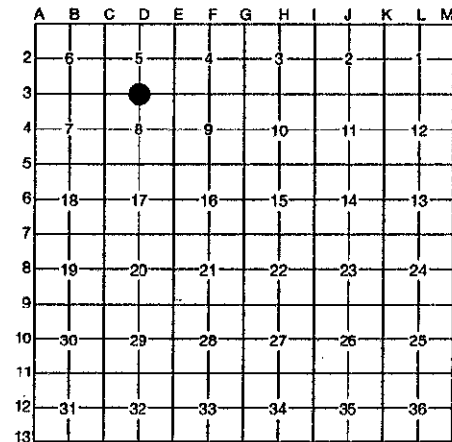

A. Description of original monument and accessories and/or subsequent restoration:

Corner established by Wills Burt, U.S. Deputy Surveyor, June 1851.
Set Post.

Original Bearing Trees:

W. Pine	40"	N66°E	13 Links	(8.58 Feet)
Fir	10"	S08°W	22 Links	(14.52 Feet)

B. Description of corner evidence found and/or method applied in restoring or reestablishing corner:

No evidence of original corner or bearing trees were found. Area has been farmed extensively. Corner position is on an abandoned County Road, built in the early 1900's. Corner was set by a single proportionate measurement on a line between the NW & NE Corner of Section 8. This corner was one of the corners re-monumented in a Block of 6 Sections in which all original corners were re-established.

Research on file with County Remonumentation Program Representative.

PEER GROUP APPROVED

Earl W. Applekamp 8-08-95

COUNTY REPRESENTATIVE

C. Description of monument for corner and accessories established to perpetuate locating the position of the corner:

At the corner position I set a 2 $\frac{1}{4}$ "x30" split aluminum pipe with a 3 $\frac{1}{4}$ " cap stamped to read: $\frac{1}{4}$, S5, S8, T48N R41W, 1995, P.S. 17610. I established the following witnesses:

7" Elm	N69°W	81.10 Feet	High Point on a 6'x3' Rock
			N14°-30"W 33.95 Feet
8" Aspen	S62°E	55.10 Feet	Steel Sign Post North 1.37 Feet



Signed by Earl W. Applekamp

Date June 18, 1995

Surveyor's Michigan License No. 17610