

SURVEY & REMONUMENTATION

APR 29 1996

COMMISSION

JUDITH D. ROEHM
 Ontonagon County
 LC 3/288 JEM Fee: 9.00
 08/09/95
 13:37
 Page 1 of 1

LAND CORNER RECORDATION CERTIFICATE
Filing Requirement of Act 74, Mich. P.A. 1970

For corners in	Located In:	Corner Code #
<u>ONTONAGON</u> (County)		
1. Public Land Survey	T <u>48</u> R <u>41</u>	<u>D-5</u>
	T _____ R _____	_____
	T _____ R _____	_____
	T _____ R _____	_____
2. Property Controlling in Section	S _____ T _____ R _____	_____
	S _____ T _____ R _____	_____
3. Miscellaneous Property in Section	S _____ T _____ R _____	_____
	S _____ T _____ R _____	_____

Register of Deeds Stamp & File Number

4. Lot No. _____, Recorded Plat _____
 5. Private Claims _____

$\frac{1}{4}$ Corner common to Section 8 & 17, T48N R41W.

I, Earl W. Applekamp, in a field survey on June 20, 19 95, do hereby certify that under requirements of P.A. 74, Michigan P.A. of 1970, the corner points mentioned in lines 1 and 2 above were in conformance with regulations and rules therefore as required in the current manual of survey instructions of the United States Department of the Interior, Bureau of Land Management or by a decree of a Court of Law and/or the corner points mentioned in lines 3, 4 and 5 above were in conformance with the rules of the Michigan Board of Professional Surveyors or by a Decree of a Court of Law; established, re-established, monumented, re-monumented, recovered, found as expressed below:

NOTE: Not more than 4 corners, all in the same town and range, may be recorded on this certificate.

A	B	C	D	E	F	G	H	I	J	K	L	M
2	6		5		4		3		2			
3												
4	7		8		9		10		11		12	
5			●									
6	18		17		16		15		14		13	
7												
8	19		20		21		22		23		24	
9												
10	30		29		28		27		26		25	
11												
12	31		32		33		34		35		36	
13												

A. Description of original monument and accessories and/or subsequent restoration:

Original corner established by Wills Burt, U.S. Deputy Surveyor, summer 1851. Set Post.

ORIGINAL BEARING TREES:


Tamarack 11" S27°E 34 Links (22.44 feet)
 Spruce 8" N13°W 17 Links (11.22 feet)

B. Description of corner evidence found and/or method applied in restoring or reestablishing corner:

No evidence of original corner was found. Corner location is on the edge of a field. Corner was re-established by single proportionate measurement between opposite section corners lying East & West. This corner was one of 29 corners in 6 sections remonumented under the County Remonumentation Program. Research is on file with the Ontonagon county Remonumentation Program Representative.

PEER GROUP APPROVED

Earl W. Applekamp 8-08-95
COUNTY REPRESENTATIVE

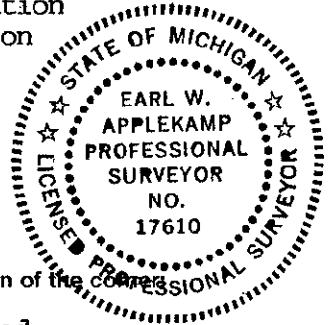

C. Description of monument for corner and accessories established to perpetuate locating the position of the corner:

At the corner position I set a 2 1/4" aluminum pipe with a 3 1/4" cap stamped to read: COUNTY REMONUMENTATION, 1/4, S8, S17, T48N R41W, 1995, P.S. 17610. I established the following bearing trees and reference objects:

6" Aspen N58°W 93.95 feet - 6" Cherry N42°E 79.12 feet
 8" Aspen N09°E 64.17 feet - Steel Sign Post South 1.00 feet

Signed by Earl W. Applekamp Date July 31, 1995
 Surveyor's Michigan License No. 17610