

APR 29 1996

COMMISSION

JUDITH D. ROEHM
Ontonagon County
LC 3/291 JEM Fee: 9.00
08/09/95
13:45
Page 1 of 1

LAND CORNER RECORDATION CERTIFICATE
Filing Requirement of Act 74, Mich. P.A. 1970

For corners in
ONTONAGON
(County)

Located In:

Corner Code #


- | | | | | | | |
|--------------------------------------|---|-----------|---|-----------|------------|-------|
| 1. Public Land Survey | T | <u>48</u> | R | <u>41</u> | <u>E-2</u> | |
| | T | _____ | R | _____ | _____ | |
| | T | _____ | R | _____ | _____ | |
| | T | _____ | R | _____ | _____ | |
| 2. Property Controlling in Section | S | _____ | T | _____ | R | _____ |
| | S | _____ | T | _____ | R | _____ |
| 3. Miscellaneous Property in Section | S | _____ | T | _____ | R | _____ |
| | S | _____ | T | _____ | R | _____ |

Register of Deeds Stamp & File Number

4. Lot No. _____, Recorded Plat _____

5. Private Claims _____

$\frac{1}{4}$ Corner common to Sections 4 & 5, T48N R41W

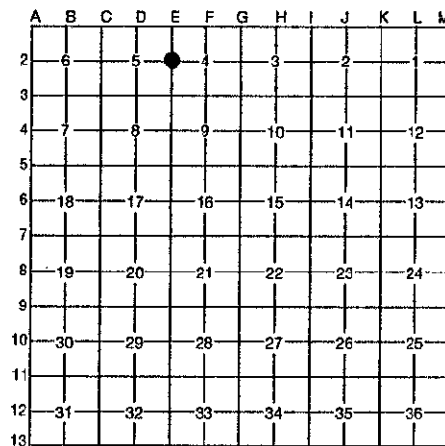

I, Earl W. Applekamp, in a field survey on June 6, 19 95, do hereby certify that under requirements of P.A. 74, Michigan P.A. of 1970, the corner points mentioned in lines 1 and 2 above were in conformance with regulations and rules therefore as required in the current manual of survey instructions of the United States Department of the Interior, Bureau of Land Management or by a decree of a Court of Law and/or that the corner points mentioned in lines 3, 4 and 5 above were in conformance with the rules of the Michigan Board of Professional Surveyors or by a Decree of a Court of Law; established, re-established, monumented, re-monumented, recovered, found as expressed below:

NOTE: Not more than 4 corners, all in the same town and range, may be recorded on this certificate.

A. Description of original monument and accessories and/or subsequent restoration:

Corner established by Wills Burt, U.S. Deputy Surveyor, June 1851.
Set Post.

Original Bearing Trees:

- | | | | | |
|---------|-----|-------|----------|--------------|
| W. Pine | 30" | S54°E | 33 Links | (21.78 Feet) |
| W. Pine | 40" | S46°W | 21 Links | (13.86 Feet) |

B. Description of corner evidence found and/or method applied in restoring or reestablishing corner:

No evidence of original corner or bearing trees were found. Corner position is on a gravel road which has been in existence since early 1900. Corner was established by single proportionate measurement between NE & SE corner of Section 5 and using the centerline of the Township road at the $\frac{1}{4}$ corner as the Section line. This corner was one of the corners remonumented in a Block of 6 sections in which all original corners were re-established. Research on file with the County Remonumentation Program.

BEER GROUP APPROVED

Earl W. Applekamp 8-08-95
COUNTY REPRESENTATIVE

C. Description of monument for corner and accessories established to perpetuate locating the position of the corner:

At the corner position I set a $\frac{3}{4}$ "x18" aluminum rod with a $\frac{3}{4}$ " cap stamped to read: COUNTY REMONUMENTATION, $\frac{1}{4}$, S4, S5, T48N R41W, 1995, P.S. 17610. Monument is 6" below top of gravel in the centerline of a Township road. A witness monument was set and the cap is stamped the same as above. I established the following witnesses:

- | | | | | |
|-------------|-------|------------|------------------|------------------|
| 5" Red Pine | N52°W | 51.76 Feet | - Witness Corner | West 34.83 Feet |
| 7" Aspen | S67°E | 40.43 Feet | - P. Pole | S28°W 63.30 Feet |



Signed by Earl W. Applekamp
Surveyor's Michigan License No. 17610

Date June 18, 1995