

SURVEY & REMONUMENTATION

APR 29 1996

JUDITH D. ROEHM
 Ontonagon County
 LC 3/299 JEM Fee: 9.00
 Page 1 of 1

COMMISSION LAND CORNER RECORDATION CERTIFICATE
 Filing Requirement of Act 74, Mich. P.A. 1970

For corners in ONTONAGON
 (County)

Located In: Corner Code #


- | | | |
|--------------------------------------|-------------------------|------------|
| 1. Public Land Survey | T <u>48</u> R <u>41</u> | <u>E-5</u> |
| | T _____ R _____ | _____ |
| | T _____ R _____ | _____ |
| | T _____ R _____ | _____ |
| 2. Property Controlling in Section | S _____ T _____ R _____ | _____ |
| | S _____ T _____ R _____ | _____ |
| 3. Miscellaneous Property in Section | S _____ T _____ R _____ | _____ |
| | S _____ T _____ R _____ | _____ |

Register of Deeds Stamp & File Number

4. Lot No. _____, Recorded Plat _____
 5. Private Claims _____

Section Corner common to Sections 8, 9, 16 & 17,
 T 48N R41W

I, Earl W. Applekamp, the field survey on December 26, 1994
 do hereby certify that under requirements of P.A. 74, Michigan P.A. of 1970, the corner points mentioned in lines 1 and 2 above were in conformance with regulations and rules therefore as required in the current manual of survey instructions of the United States Department of the Interior, Bureau of Land Management or by a decree of a Court of Law and/or that the corner points mentioned in lines 3, 4 and 5 above were in conformance with the rules of the Michigan Board of Professional Surveyors or by a Decree of a Court of Law; established, re-established, monumented, re-monumented, recovered, found as expressed below:

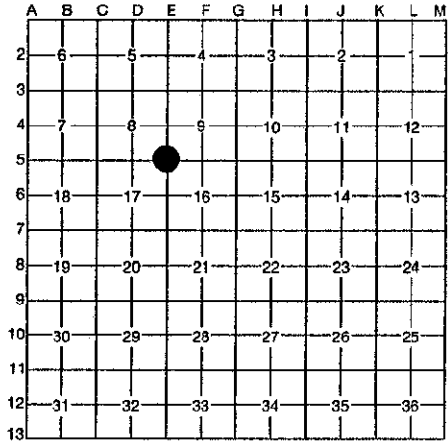

NOTE: Not more than 4 corners, all in the same town and range, may be recorded on this certificate.

A. Description of original monument and accessories and/or subsequent restoration:

Corner established by Wills Burt, U.S. Deputy Surveyor, June 1851.
 Set Post.

Original Bearing Trees:

Spruce 8" N02°E 6 Links (3.96 Feet)
 Tamarack 14" S48°W 24 Links (15.84 Feet)

B. Description of corner evidence found and/or method applied in restoring or reestablishing corner:

Corner position was marked with a barb wire fence going in four directions and has been there for 50 plus years. Position is in agreement with original field note. This corner was one of the corners re-monumented in a Block of 6 Sections in which original corners were re-established.

Research on file with the County Remonumentation Program Representative.

PEER GROUP APPROVED
Earl W. Applekamp 8-08-95
 COUNTY REPRESENTATIVE



C. Description of monument for corner and accessories established to perpetuate locating the position of the corner:

At the corner position, I set a 2 1/4"x30" split base aluminum pipe with a 3 1/4" cap stamped to read: COUNTY REMONUMENTATION, S8, S9, S16, S17, t48N R41W, 1995, P.S. 17610. I established the following witness trees and objects:

5" Aspen S69°E 51.40 Feet Fence Post N06°E 22.21 Feet
 Fence Post N85°W 19.50 Feet Steel Sign Post South 1.72 Feet

Signed by Earl W. Applekamp
 Surveyor's Michigan License No. 17610

Date June 13, 1995