

LAND CORNER RECORDATION CERTIFICATE  
 Filing Requirement of Act 74, Mich. P.A. 1970

For corners in


<u>ONTONAGON</u> (County)	Located In:	Corner Code #
1. Public Land Survey	T <u>48NR 41W</u>	<u>E-9</u>
	T <u>   R</u>	<u>   </u>
	T <u>   R</u>	<u>   </u>
	T <u>   R</u>	<u>   </u>
2. Property Controlling in Section	S <u>   T</u>	<u>   R</u>
	S <u>   T</u>	<u>   R</u>
3. Miscellaneous Property in Sec.	S <u>   T</u>	<u>   R</u>
	S <u>   T</u>	<u>   R</u>

REMONUMENTATION  
 OCT 3 1997  
 COMMISSIONER  
 Register of Deeds Stamp & File Number

4. Lot No. \_\_\_\_\_, Recorded Plat \_\_\_\_\_  
 5. Private Claims \_\_\_\_\_

Section Corner common to Sections 20, 21, 28, & 29, T48N R41W.

I, Earl W. Applekamp, in a field survey on Aug. 11, 1997 do hereby state that under requirements of P.A. 74, Michigan P.A. of 1970, the corner points mentioned in lines 1 and 2 above were in conformance with regulations and rules therefore as required in the current manual of survey instructions of the United States Department of the Interior, Bureau of Land Management or by a decree of a Court of Law and/or that the corner points mentioned in lines 3, 4 and 5 above were in conformance with the rules of the Michigan Board of Land Surveyors or by a Decree of a Court of Law; established, re-established, monumented, recovered, found as expressed below:

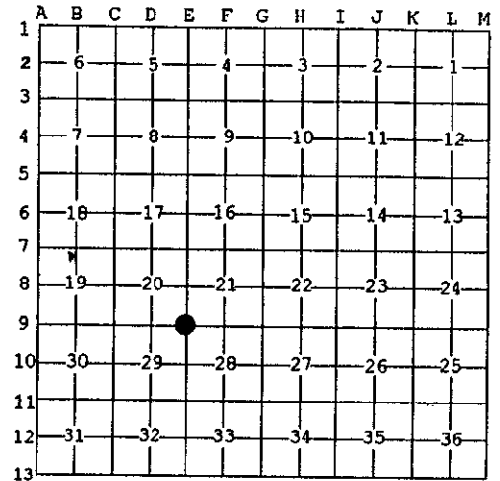

NOTE: Not more than 2 corners, all in the same town and range, may be recorded on this certificate.

A. Description of original monument and accessories and/or subsequent restoration:

Original corner established by Wells Burt, U.S. Deputy Surveyor, June 14, 1851. Set Wood Post.

ORIGINAL BEARING TREES:

12" Lynn N51°W 15.18 feet  
 8" Fir S40°W 18.48 feet

B. Description of corner evidence found and/or method applied in restoring or reestablishing corner:

No original evidence was found. At the apparent corner position, a blacktop road (old M-28) runs East & West. This road has been in use since about 1910. The corner was re-established by proportionate measure between opposite section corners East & West and in the centerline of the blacktop road. Occupation lines are obvious in all four directions. This is the only logical position for the corner.

Research on file with the Ontonagon County Remonumentation Program Representative.

PEER GROUP APPROVED  
Earl W. Applekamp  
 COUNTY REPRESENTATIVE  
 9-17-97

C. Description of monument for corner and accessories established to perpetuate locating the position of the corner:

At the corner position I set a 5/8"x8" rebar with a 3" stamped cap 1 1/2" below top of blacktop. I established a reference monument, a 2 1/2"x30" aluminum pipe with a 3" cap stamped to read: County Remonumentation, T48N R41W, R.M., S20, S21, S28, S29, 1997, P.S. 17610. I also established three other reference objects.

REF. MON. S00°-40'-52"E 39.10' - 9 1/2" Elm N02°-29'-07"W 63.18'  
 12" Red Pine S70°-01'-48"W 124.91' - Power Pole N68°-21'-36"E 81.10'



Signed by Earl W. Applekamp  
 Surveyor's Michigan License No. 17610

Date September 6, 1997