

**LAND CORNER RECORDATION CERTIFICATE**  
 Filing Requirement of Act 74, Mich. P.A. 1970

For corners in

<u>ONTONAGON</u> (County)	Located In:	Corner Code #
1. Public Land Survey	T 48N R 41W	E-12
	T _____ R _____	_____
	T _____ R _____	_____
	T _____ R _____	_____
2. Property Controlling in Section	S _____ T _____ R _____	_____
	S _____ T _____ R _____	_____
3. Miscellaneous Property in Sec.	S _____ T _____ R _____	_____
	S _____ T _____ R _____	_____

**SURVEY &  
REMONUMENTATION**

**MAR 23 2000**

**SECTION**

Register of Deeds Stamp & File Number

4. Lot No. \_\_\_\_\_, Recorded Plat \_\_\_\_\_  
 5. Private Claims \_\_\_\_\_

$\frac{1}{4}$  Corner common to Sections 32 & 33, T48N R41W.

I, Earl W. Applekamp, in a field survey on Oct. 18, 1999 do hereby state that under requirements of P.A. 74, Michigan P.A. of 1970, the corner points mentioned in lines 1 and 2 above were in conformance with regulations and rules therefore as required in the current manual of survey instructions of the United States Department of the Interior, Bureau of Land Management or by a decree of a Court of Law and/or that the corner points mentioned in lines 3, 4 and 5 above were in conformance with the rules of the Michigan Board of Land Surveyors or by a Decree of a Court of Law; established, re-established, monumented, recovered, found as expressed below:

NOTE: Not more than 2 corners, all in the same town and range, may be recorded on this certificate.

	A	B	C	D	E	F	G	H	I	J	K	L	M
1													
2	6		5		4		3		2		1		
3													
4	7		8		9		10		11		12		
5													
6	18		17		16		15		14		13		
7													
8	19		20		21		22		23		24		
9													
10	30		29		28		27		26		25		
11													
12	31		32		33		34		35		36		
13													

A. Description of original monument and accessories and/or subsequent restoration:

Original corner established by Wells Burt, U.S. Deputy Surveyor, June 1851. Set Wood Post.

ORIGINAL BEARING TREES:

30" Sugar S55°E 6 Links (3.96 feet)  
 12" Maple S05°W 16 Links (10.56 feet)

B. Description of corner evidence found and/or method applied in restoring or reestablishing corner:

No original or subsequent evidence of the corner was found. Corner was re-established by single proportionate measure and on line between opposite section corners North & South.


Research on file with the Ontonagon County Remonumentation Program Representative.

**DEED GROUP APPROVED**  
*Earl W. Applekamp* 11-09-99  
 COUNTY REGISTER & CLERK

C. Description of monument for corner and accessories established to perpetuate locating the position of the corner:

At the corner position I set a 2 $\frac{1}{2}$ "x30" aluminum pipe with a 3" cap stamped to read: County Remonumentation, T48N, R41W,  $\frac{1}{4}$ , S32, S33, 1999, P.S. 17610. I established 3 bearing trees and a reference object.

Nail in 4" Aspen N62°W 28.13' - Nail in 6" Aspen S42°W 70.27'  
 Nail in 6" Aspen S01°W 78.37' - 6' Steel Sign Post East 0.70'

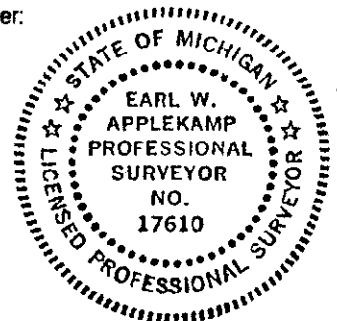

Signed by *Earl W. Applekamp*  
 Surveyor's Michigan License No. 17610

Date October 22, 1999