

LAND CORNER RECORDATION CERTIFICATE
Filing Requirement of Act 74, Mich. P.A. 1970

For corners in

Located in:	Corner Code #
ONTONAGON (County) GOGEBIC	
1. Public Land Survey	T48N R 41W E-13 ✓ T47N R 41W E-1
2. Property Controlling in Section	T R T R S T R S T R
3. Miscellaneous Property in Sec.	S T R S T R

SURVEY & REMONUMENTATION


MAR 23 2000

SECTION
Register of Deeds Stamp & File Number

4. Lot No. _____, Recorded Plat _____
5. Private Claims _____

Section Corner common to Sections 32 & 33, T48N R41W & Sections 4 & 5, T47N R41W.
I, Earl W. Applekamp, in a field survey on Oct. 01, 1999 do hereby state that under requirements of P.A. 74, Michigan P.A. of 1970, the corner points mentioned in lines 1 and 2 above were in conformance with regulations and rules therefore as required in the current manual of survey instructions of the United States Department of the Interior, Bureau of Land Management or by a decree of a Court of Law and /or that the corner points mentioned in lines 3, 4 and 5 above were in conformance with the rules of the Michigan Board of Land Surveyors or by a Decree of a Court of Law; established, re-established, monumented, recovered, found as expressed below:

NOTE: Not more than 2 corners, all in the same town and range, may be recorded on this certificate.

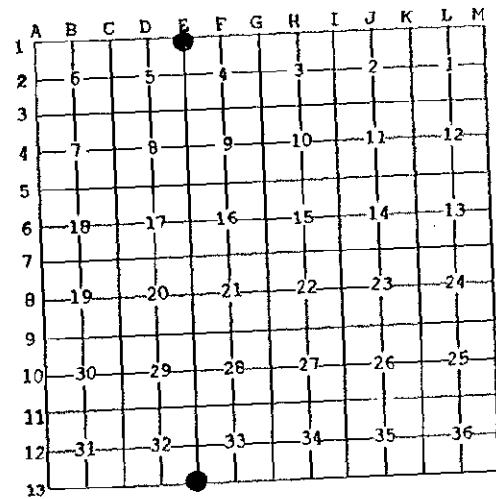

A. Description of original monument and accessories and/or subsequent restoration:
Original corner established by William A. Burt, U.S. Deputy Surveyor in 1847. Set Cedar Post.

ORIGINAL BEARING TREES:

Hemlock 14"	N35°E	4 Links (2.64 feet)
Hemlock 14"	N65°W	18 Links (11.88 feet)

DEED GROUP APPROVED
Earl W. Applekamp
COURT REGISTER & CLERK
10-14-99

B. Description of corner evidence found and/or method applied in restoring or reestablishing corner:
No original or subsequent evidence was found. Corner was re-established by single proportionate measure and on the Town Line between the monumented South 1/4 Corner of Section 32 and the Southeast Corner of Section 33.

Research on file with the Ontonagon County Remonumentation Program Representative.

C. Description of monument for corner and accessories established to perpetuate locating the position of the corner:
At the corner position I set a 2 1/2"x30" split base aluminum pipe with a 3" cap stamped to read: County Remonumentation, T48N, T47N, R41W, S33, S32, S5, S4, 1999, P.S. 17610. I established 3 bearing trees and a reference object.

Nail in 8" Soft Maple	S45°W 39.82'	- Nail in 6" S. Maple	N56°E 34.52'
Nail in 7" Soft Maple	N74°W 48.62'	- 6' Steel Sign Post	North 0.56'



Signed by Earl W. Applekamp
Surveyor's Michigan License No. _____ 17610

Date October 4, 1999