

LAND CORNER RECORDATION CERTIFICATE
 Filing Requirement of Act 74, Mich. P.A. 1970

For corners in

<u>ONTONAGON</u> (County)	Located In: _____	Corner Code # _____
1. Public Land Survey	T <u>48N</u> R <u>41W</u>	<u>E-5</u>
	T _____ R _____	_____
	T _____ R _____	_____
	T _____ R _____	_____
2. Property Controlling in Section	S _____ T _____ R _____	_____
	S _____ T _____ R _____	_____
3. Miscellaneous Property in Sec.	S _____ T _____ R _____	_____
	S _____ T _____ R _____	_____

SURVEY & REMONUMENTATION

APR 07 1998

SECTION

Register of Deeds Stamp & File Number

4. Lot No. _____, Recorded Plat _____
 5. Private Claims _____

1/4 Corner common to Sections 9 & 16, T48N R41W.

I, Earl W. Applekamp, in a field survey on Oct. 16, 1997 do hereby state that under requirements of P.A. 74, Michigan P.A. of 1970, the corner points mentioned in lines 1 and 2 above were in conformance with regulations and rules therefore as required in the current manual of survey instructions of the United States Department of the Interior, Bureau of Land Management or by a decree of a Court of Law and /or that the corner points mentioned in lines 3, 4 and 5 above were in conformance with the rules of the Michigan Board of Land Surveyors or by a Decree of a Court of Law; established, re-established, monumented, recovered, found as expressed below:

NOTE: Not more than 2 corners, all in the same town and range, may be recorded on this certificate.

	A	B	C	D	E	F	G	H	I	J	K	L	M
1													
2	6		5		4		3		2		1		
3													
4	7		8		9		10		11		12		
5													
6	18		17		16		15		14		13		
7													
8	19		20		21		22		23		24		
9													
10	30		29		28		27		26		25		
11													
12	31		32		33		34		35		36		
13													

A. Description of original monument and accessories and/or subsequent restoration:

Original corner established by Wells Burt, U.S. Deputy Surveyor, June 15, 1851. Set Wood Post.

ORIGINAL BEARING TREES:

12" W. Birch	N58°W	17.16 feet
6" Maple	S80°E	5.94 feet

PEER GROUP APPROVED

Earl W. Applekamp
 COUNTY SURVEYOR

11-11-97

B. Description of corner evidence found and/or method applied in restoring or reestablishing corner:


No original evidence was found. Area has been cleared and pastured. Corner was re-established by single proportionate measurement between opposite Section corners East & West. At this corner location there is remnants of an old fence line running North. Corner location is in a swamp.

Research on file with the Ontonagon County Remonumentation Program Representative.

C. Description of monument for corner and accessories established to perpetuate locating the position of the corner:

At the corner position I set a 2 1/2"X30" split base aluminum monument with a 3" cap stamped to read: County Remonumentation, T48N R41W, 1/4, S9, S16, 1997, P.S. 17610. I established three bearing trees and a reference object.

13" Aspen	N82°W	76.10'	-	6" Aspen	S73°W	71.05'
6" Aspen	S81°W	57.45'	-	6" Steel Sign Post, East		0.80'

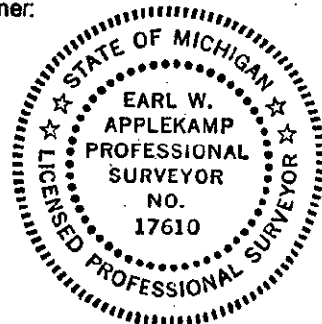

Signed by Earl W. Applekamp
 Surveyor's Michigan License No. 17610

Date October 20, 1997