

LAND CORNER RECORDATION CERTIFICATE
 Filing Requirement of Act 74, Mich. P.A. 1970

For corners in
ONTONAGON
 (County)

	Located in:	Corner Code #
1. Public Land Survey	T48N R41W	G-5
	T___ R___	_____
	T___ R___	_____
	T___ R___	_____
2. Property Controlling in Section	S___ T___ R___	_____
	S___ T___ R___	_____
3. Miscellaneous Property in Sec.	S___ T___ R___	_____
	S___ T___ R___	_____

SURVEY & REMONUMENTATION

APR 07 1998


SECTION

Register of Deeds Stamp & File Number

4. Lot No. _____, Recorded Plat _____
 5. Private Claims _____

Section Corner common to 9, 10, 15, & 16.

I, Earl W. Applekamp in a field survey on Oct. 10, 1997 do hereby state that under requirements of P.A. 74, Michigan P.A. of 1970, the corner points mentioned in lines 1 and 2 above were in conformance with regulations and rules therefore as required in the current manual of survey instructions of the United States Department of the Interior, Bureau of Land Management or by a decree of a Court of Law and for that the corner points mentioned in lines 3, 4 and 5 above were in conformance with the rules of the Michigan Board of Land Surveyors or by a Decree of a Court of Law; established, re-established, monumented, recovered, found as expressed below:

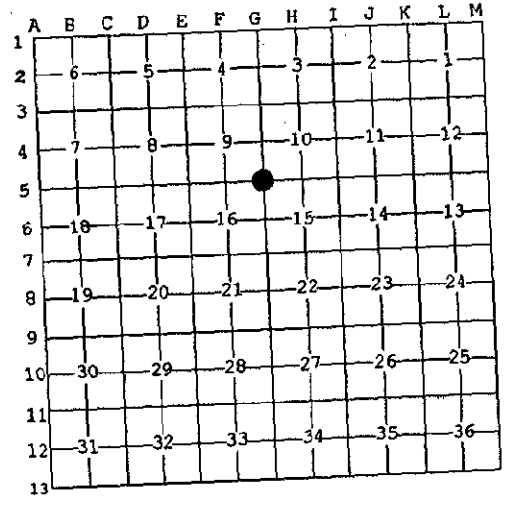

NOTE: Not more than 2 corners, all in the same town and range, may be recorded on this certificate.

A. Description of original monument and accessories and/or subsequent restoration:
 Original corner established by Wells Burt, Deputy Surveyor.
 Set Wood Post.

ORIGINAL BEARING TREES:

12" Maple	S54°W	17.82 feet
10" Elm	N34°E	9.24 feet

PEER GROUP APPROVED
Earl W. Applekamp
 COUNTY SURVEYOR 11-11-97

B. Description of corner evidence found and/or method applied in restoring or reestablishing corner:
 No original evidence was found. Area in the vicinity of the corner has been occupied for approximately 70 years. MDOT Highway drawings indicate a fence post at the corner was 370 feet North of Highway centerline. South of the highway a fence line running South has been in existence for 80 plus years. Testimony from the resident living near the corner (Ron Hilborn) showed me where he thought the corner was located before being cleared for snowplowing. From this position a line running West goes along a field-woods line. I found the distance from the highway centerline to be 434 feet. The departure of the corner was re-established at the projection North of the fence South of the Highway. The latitude was set at the woods-field line mentioned above. This position is in agreement with lines run by Champion Foresters and is consistent with the monumented Section corners East, West and South.
 Research on file with the Ontonagon County Remonumentation Program Representative.

C. Description of monument for corner and accessories established to perpetuate locating the position of the corner:
 At the corner position I set a 2 1/2"x30" split base aluminum pipe, with a 3" stamped cap 6" below top of dirt. Cap is stamped to read: County Remonumentation, T48N R41W, S9, S10, S15, S16, 1997, P.S. 17610. I established 3 bearing trees and a reference object. Measurement is to a nail in a tree.

12" Scrub Oak	S89°W	41.54'	-	6" Aspen	S70°E	25.95'
7" Spruce	N16°E	30.91'	-	Steel Sign Post, East		1.28'



Signed by Earl W. Applekamp
 Surveyor's Michigan License No. 17610

Date October 17, 1997