

LAND CORNER RECORDATION CERTIFICATE
 Filing Requirement of Act 74, Mich. P.A. 1970

For corners in

ONTONAGON (County)	Located In:	Corner Code #
1. Public Land Survey	T <u>48N</u> R <u>41W</u>	<u>G-8</u>
	T ___ R ___	_____
	T ___ R ___	_____
	T ___ R ___	_____
2. Property Controlling In Section	S ___ T ___ R ___	_____
	S ___ T ___ R ___	_____
3. Miscellaneous Property In Sec.	S ___ T ___ R ___	_____
	S ___ T ___ R ___	_____

REGISTERED
 DEPARTMENT OF
 JAN 11 1998
 SECTON
 Register of Deeds Stamp & File Number

4. Lot No. _____, Recorded Plat _____
 5. Private Claims _____

	A	B	C	D	E	F	G	H	I	J	K	L	M
1													
2	6		5		4		3		2		1		
3													
4	7		8		9		10		11		12		
5													
6	18		17		16		15		14		13		
7													
8	19		20		21		22		23		24		
9													
10	30		29		28		27		26		25		
11													
12	31		32		33		34		35		36		
13													

1/4 Corner common to Sections 21 & 22, T48N R41W.
 I, Earl W. Applekamp, in a field survey on July 24, 1998 do hereby state that under requirements of P.A. 74, Michigan P.A. of 1970, the corner points mentioned in lines 1 and 2 above were in conformance with regulations and rules therefore as required in the current manual of survey instructions of the United States Department of the Interior, Bureau of Land Management or by a decree of a Court of Law and/or that the corner points mentioned in lines 3, 4 and 5 above were in conformance with the rules of the Michigan Board of Land Surveyors or by a Decree of a Court of Law, established, re-established, monumented, recovered, found as expressed below:

NOTE: Not more than 2 corners, all in the same town and range, may be recorded on this certificate.

A. Description of original monument and accessories and/or subsequent restoration:
 Original corner established by Wells Burt, U.S. Deputy Surveyor, June 16, 1851. Set Wood Post.


ORIGINAL BEARING TREES:
 14" Tamarack N78°W 13.20 feet
 10" Tamarack N75°E 3.96 feet

FEER GROUP APPROVAL
Earl W. Applekamp
 COUNTY _____ 8-19-98

B. Description of corner evidence found and/or method applied in restoring or reestablishing corner:
 No original or other evidence was found. Corner position is in a large low lying area with no trees. Corner was re-established by single proportionate measure between opposite Section Corners North and South.

Research on file with the Ontonagon County Remonumentation Program Representative.

C. Description of monument for corner and accessories established to perpetuate locating the position of the corner:
 At the corner position I set a 2 1/2"x30" split base aluminum pipe with a 3" cap stamped to read: County Remonumentation, T48N R41W, 1/4, S21, S22, 1998, P.S. 17610. I established three bearing trees and a reference object.

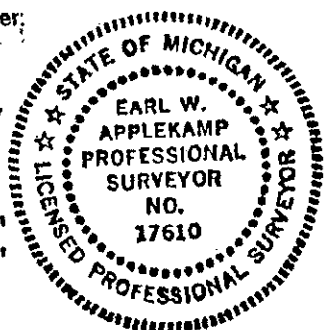

Nail in 5" Spruce S32°W 212.59' - Nail in 4" Spruce S56°W 175.36'
 Nail in 6" Spruce S52°W 206.35' - Steel Sign Post N45°E 0.61'

Signed by Earl W. Applekamp
 Surveyor's Michigan License No. 17610

Date August 17, 1998