

LAND CORNER RECORDATION CERTIFICATE
 Filing Requirement of Act 74, Mich. P.A. 1970

For corners in

<u>ONTONAGON</u> (County)	Located In:	Corner Code #
1. Public Land Survey	T48N R 41W	G-10
	T ___ R ___	_____
	T ___ R ___	_____
	T ___ R ___	_____
2. Property Controlling in Section	S ___ T ___ R ___	_____
	S ___ T ___ R ___	_____
3. Miscellaneous Property In Sec.	S ___ T ___ R ___	_____
	S ___ T ___ R ___	_____

**SURVEY &
 REMONUMENTATION**

MAR 28 2000

SECTION

Register of Deeds Stamp & File Number

4. Lot No. _____, Recorded Plat _____
 5. Private Claims _____

1/4 Corner common to Sections 27 & 28, T48N R41W.

I, Earl W. Applekamp, in a field survey on Aug. 14, 1999 do hereby state that under requirements of P.A. 74, Michigan P.A. of 1970, the corner points mentioned in lines 1 and 2 above were in conformance with regulations and rules therefore as required in the current manual of survey instructions of the United States Department of the Interior, Bureau of Land Management or by a decree of a Court of Law and/or that the corner points mentioned in lines 3, 4 and 5 above were in conformance with the rules of the Michigan Board of Land Surveyors or by a Decree of a Court of Law; established, re-established, monumented, recovered, found as expressed below:

NOTE: Not more than 2 corners, all in the same town and range, may be recorded on this certificate.

A	B	C	D	E	F	G	H	I	J	K	L	M
1												
2	6	5	4	3	2	1						
3												
4	7	8	9	10	11	12						
5												
6	18	17	16	15	14	13						
7												
8	19	20	21	22	23	24						
9												
10	30	29	28	27	26	25						
11												
12	31	32	33	34	35	36						
13												

A. Description of original monument and accessories and/or subsequent restoration:

Original corner established by Wells Burt, U.S. Deputy Surveyor, June 15, 1851. Set Wood Post.

ORIGINAL BEARING TREES:

8" Maple	S37°W	19.14 feet
12" Black Ash	N60°E	21.78 feet

B. Description of corner evidence found and/or method applied in restoring or reestablishing corner:

No original evidence remains. A county road runs along the Section line North & South. No subsequent evidence was found. Corner was re-established by single proportionate measure and on line between opposite section corners North and South.


Research on file with the Ontonagon County Remonumentation Program Representative.

PEER GROUP APPROVED

Earl W. Applekamp 8-24-99
 COUNTY REPRESENTATIVE

C. Description of monument for corner and accessories established to perpetuate locating the position of the corner:

At the corner position I set a 5/8"x12" rebar with a 3" cap 5" below top of gravel and in the center-line of the gravel road. Cap is stamped to read: County Remonumentation, T48, R41W, 1/4, S27, S28, 1999, P.S. 17610. I established a reference monument, a 2 1/2"x30" split base aluminum pipe with a 3" cap stamped same as above, except adding R.M. I established three other reference objects.

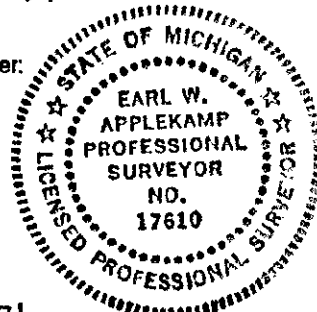

REF. MON.	S87°-21'-20"W	49.39'	- Nail in 8" Aspen	S48°W	51.67'
	Nail in 6" Tamarack	N69°W	42.23'	- Nail in P. Pole	N29°E 60.58'

Signed by Earl W. Applekamp
 Surveyor's Michigan License No. 17610

Date August 20, 1999