

LAND CORNER RECORDATION CERTIFICATE
 Filing Requirement of Act 74, Mich. P.A. 1970

For corners in

ONTONAGON
 (County)

Located In:

Corner Code #

- | | | |
|---------------------------------------|--|-------------|
| 1. Public Land Survey | T <u>48N</u> R <u>41W</u> | <u>G-11</u> |
| | T <u> </u> R <u> </u> | <u> </u> |
| | T <u> </u> R <u> </u> | <u> </u> |
| | T <u> </u> R <u> </u> | <u> </u> |
| 2. Property Controlling
In Section | S <u> </u> T <u> </u> R <u> </u> | <u> </u> |
| | S <u> </u> T <u> </u> R <u> </u> | <u> </u> |
| 3. Miscellaneous
Property In Sec. | S <u> </u> T <u> </u> R <u> </u> | <u> </u> |
| | S <u> </u> T <u> </u> R <u> </u> | <u> </u> |

**SURVEY &
 REMONUMENTATION**
MAR 28 2000
SECTION


Register of Deeds Stamp & File Number

4. Lot No. _____, Recorded Plat _____
 5. Private Claims _____

Section Corner common to Sections 27, 28, 33 & 34, T48N R41W.

I, Earl W. Applekamp, in a field survey on Aug. 14, 1999 do hereby state that under requirements of P.A. 74, Michigan P.A. of 1970, the corner points mentioned in lines 1 and 2 above were in conformance with regulations and rules therefore as required in the current manual of survey instructions of the United States Department of the Interior, Bureau of Land Management or by a decree of a Court of Law and/or that the corner points mentioned in lines 3, 4 and 5 above were in conformance with the rules of the Michigan Board of Land Surveyors or by a Decree of a Court of Law; established, re-established, monumented, recovered, found as expressed below:

NOTE: Not more than 2 corners, all in the same town and range, may be recorded on this certificate.

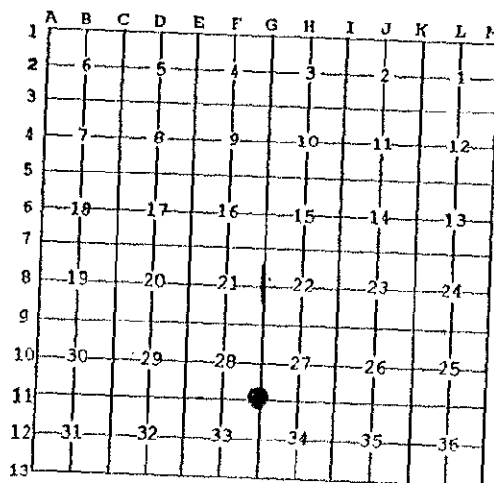

A. Description of original monument and accessories and/or subsequent restoration:

Original corner established by Wells Burt, U.S. Deputy Surveyor, June 15, 1851. Set Wood Post.

ORIGINAL BEARING TREES:

- | | | |
|-----------|-------|-----------|
| 10" Cedar | N14°W | 9.24 feet |
| 14" Cedar | S64°E | 7.92 feet |

DEER GROUP APPROVED
Earl W. Applekamp 8-24-99
 COUNTY REGISTER

B. Description of corner evidence found and/or method applied in restoring or reestablishing corner:


No original evidence was found. Corner is on a North-South gravel county road. At the apparent corner position there is an improved road running West and a fence running East. This fence has been in existence for 60 + years, is in excellent shape now and being used to contain cattle. Testimony from 86 year old Irene Hokens, stated that her father built the fence about 1930 for the South line of Section 27. I used the fence for the latitude and the center of the road for departure and monumented the corner as shown below, this being the only logical position for the corner.

Research on file with the Ontonagon County Remonumentation Program Representative

C. Description of monument for corner and accessories established to perpetuate locating the position of the corner:

At the corner position I set a 5/8"X12" rebar with a 3" cap 4" below top of gravel. Cap is stamped to read: County Remonumentation, T48N R41W, S27, S28, S33, S34, 1999, P.S. 17610. I established a reference monument, a 2 1/2"X30" split base aluminum pipe with a 3" cap, stamped the same as above, except adding a R.M. I also established 3 other bearing objects.

- | | | | | | | |
|-----------------|---------------|---------|---|-------------------|-------|---------|
| REF. MON. | N41°-21'-31"W | 70.56' | - | Nail in 11" Aspen | S43°E | 73.59' |
| Nail in P. Pole | S04°E | 193.98' | - | Nail in P. Pole | N16°E | 141.47' |

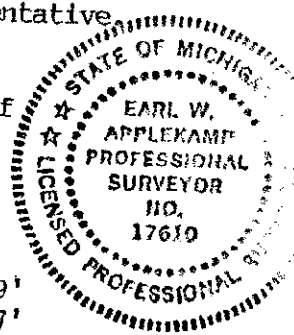

Signed by Earl W. Applekamp

Date August 16, 1999

Surveyor's Michigan License No. 17610