

LAND CORNER RECORDATION CERTIFICATE
 Filing Requirement of Act 74, Mich. P.A. 1970

For corners in

| ONTONAGON (County) | Located In: | Corner Code # |
|---------------------------------------|-------------------|---------------|
| 1. Public Land Survey | T 48NR 41W | G-12 |
| | T ___ R ___ | _____ |
| | T ___ R ___ | _____ |
| | T ___ R ___ | _____ |
| 2. Property Controlling In Section | S ___ T ___ R ___ | _____ |
| | S ___ T ___ R ___ | _____ |
| 3. Miscellaneous Property In Sec. | S ___ T ___ R ___ | _____ |
| | S ___ T ___ R ___ | _____ |

**SURVEY &
 REMONUMENTATION**

MAR 23 2000

SECTION

Register of Deeds Stamp & File Number

4. Lot No. _____, Recorded Plat _____
 5. Private Claims _____

1/4 Corner common to Sections 33 & 34, T48N R41W.

I, Earl W. Applekamp, in a field survey on Aug. 10, 1999 do hereby state that under requirements of P.A. 74, Michigan P.A. of 1970, the corner points mentioned in lines 1 and 2 above were in conformance with regulations and rules therefore as required in the current manual of survey instructions of the United States Department of the Interior, Bureau of Land Management or by a decree of a Court of Law and/or that the corner points mentioned in lines 3, 4 and 5 above were in conformance with the rules of the Michigan Board of Land Surveyors or by a Decree of a Court of Law; established, re-established, monumented, recovered, found as expressed below:

NOTE: Not more than 2 corners, all in the same town and range, may be recorded on this certificate.

| | A | B | C | D | E | F | G | H | I | J | K | L | M |
|----|----|---|----|---|----|---|----|---|----|---|----|---|---|
| 1 | | | | | | | | | | | | | |
| 2 | 6 | | 5 | | 4 | | 3 | | 2 | | 1 | | |
| 3 | | | | | | | | | | | | | |
| 4 | 7 | | 8 | | 9 | | 10 | | 11 | | 12 | | |
| 5 | | | | | | | | | | | | | |
| 6 | 18 | | 17 | | 16 | | 15 | | 14 | | 13 | | |
| 7 | | | | | | | | | | | | | |
| 8 | 19 | | 20 | | 21 | | 22 | | 23 | | 24 | | |
| 9 | | | | | | | | | | | | | |
| 10 | 30 | | 29 | | 28 | | 27 | | 26 | | 25 | | |
| 11 | | | | | | | | | | | | | |
| 12 | 31 | | 32 | | 33 | | 34 | | 35 | | 36 | | |
| 13 | | | | | | | | | | | | | |

A. Description of original monument and accessories and/or subsequent restoration:

Original corner established by Wells Burt, U.S. Deputy Surveyor, June 15, 1851. Set Wood Post.

ORIGINAL BEARING TREES:


10" Spruce S20°E 13.86 feet
 11" Cedar N05°E 12.54 feet

B. Description of corner evidence found and/or method applied in restoring or reestablishing corner:

No original evidence remains. A county road runs along the apparent Section line North & South. Corner was re-established by proportionate measure and on line between opposite section corners North & South. This position is on line with well kept fences running East & West.

Research on file with the Ontonagon County Remonumentation Program Representative.

DEED GROUP APPROVAL
Earl W. Applekamp
 COUNTY REPRESENTATIVE 8-24-99

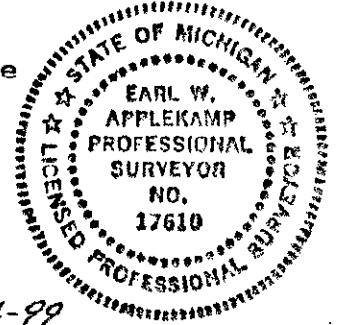

C. Description of monument for corner and accessories established to perpetuate locating the position of the corner:

At the corner position I set a 5/8"X12" rebar with a 3" cap 5" below top of gravel and in the center-line of the road. Cap is stamped to read: County Remonumentation, 1/4, T48N, R41W, S33, S34, 1999, P.S. 17610. I established a reference monument, a 2 1/2"X30" split base aluminum pipe with a 3" cap stamped same as above except adding R.M. I established three other bearing objects.

REF. MON. N80°W 41.28 feet - Nail in P. Pole N10°E 189.78 feet
 Nail in P. Pole N83°W 28.35 feet - Nail in Fence Post S88°E 25.97 feet

Signed by Earl W. Applekamp

Date August 23, 1999

Surveyor's Michigan License No. 17610