

LAND CORNER RECORDATION CERTIFICATE
Filing Requirement of Act 74, Mich. P.A. 1970

For corners in

Table with columns: Located In (ONTONAGON County), Corner Code #, and survey details (Public Land Survey, Property Controlling in Section, Miscellaneous Property In Sec.)

SURVEY & REMONUMENTATION

MAR 28 2000

SECTION

Register of Deeds Stamp & File Number

4. Lot No. Recorded Plat
5. Private Claims

Section Corner common to Sections 33 & 34, T48N R41W and Sections 3 & 4, T47N R41W.

Earl W. Applekamp, in a field survey on Aug. 10, 1999 do hereby state that under requirements of P.A. 74, Michigan P.A. of 1970, the corner points mentioned in lines 1 and 2 above were in conformance with regulations and rules therefore as required in the current manual of survey instructions of the United States Department of the Interior, Bureau of Land Management or by a decree of a Court of Law and/or that the corner points mentioned in lines 3, 4 and 5 above were in conformance with the rules of the Michigan Board of Land Surveyors or by a Decree of a Court of Law, established, re-established, monumented, recovered, found as expressed below:

NOTE: Not more than 2 corners, all in the same town and range, may be recorded on this certificate.

Grid table with columns A-L and rows 1-13, showing section numbers and corner locations.

A. Description of original monument and accessories and/or subsequent restoration:

Original Corner established by William A. Burt, U.S. Deputy Surveyor, July 17, 1851. Set Cedar Post.

ORIGINAL BEARING TREES:

10" Hemlock N38°E 9.24 feet
12" Fir N32°W 15.18 feet

DEED GROUP APPROVED
Earl W. Applekamp 8-24-99
COUNTY REPRESENTATIVE

B. Description of corner evidence found and/or method applied in restoring or reestablishing corner:


No original evidence was found. A county road would have removed any. At the apparent corner position I found a 1/2" pipe 12" below top of a gravel road. This position agrees with a fence running East and West dividing occupied land. The owner in Section 34 indicated his fence was on the line. The owner in Section 33 has lived there for 30 years and knew of the 1/2" pipe. The position is in agreement with the original field notes. I accepted the 1/2" pipe as the corner position and monumented the corner.

Research on file with the Ontonagon County Remonumentation Program Representative.

C. Description of monument for corner and accessories established to perpetuate locating the position of the corner:

At the corner position I set a 5/8"x12" rebar with a 3" cap 4" below top of ground. Cap is stamped to read: County Remonumentation, T47N, T48N, R41W, S33, S34, S3, S4, 1999, P.S. 17610. I established a reference monument, a 2 1/2"x30" split base aluminum pipe with a 3" cap stamped the same as above, adding R.M. I also established three other bearing objects.

REF. MON. N87°W 35.93' - P. Pole N41°W 37.61'
Nail in 8" Spruce S47°W 69.96' - Nail in 8" Aspen S45°E 92.38'

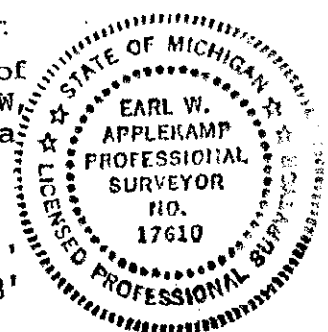

Signed by Earl W. Applekamp
Surveyor's Michigan License No. 17610

Date August 16, 1999