


LAND CORNER RECORDATION CERTIFICATE
Filing Requirement of Act 74, Mich. P.A. 1970

For corners in

ONTONAGON (County)	Located In:	Corner Code #
1. Public Land Survey	T 48NR 41W	I-8
	T R	
	T R	
	T R	
2. Property Controlling in Section	S T R	
	S T R	
3. Miscellaneous Property in Sec.	S T R	
	S T R	

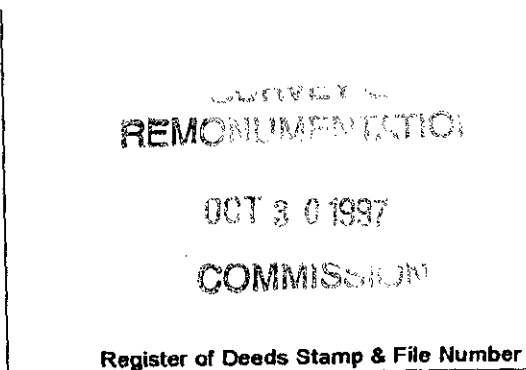

4. Lot No. _____, Recorded Plat _____
 5. Private Claims _____

1/4 Corner common to Sections 22 & 23, T48N R41W.

I, Earl W. Applekamp, in a field survey on July 30, 1997 do hereby state that under requirements of P.A. 74, Michigan P.A. of 1970, the corner points mentioned in lines 1 and 2 above were in conformance with regulations and rules therefore as required in the current manual of survey instructions of the United States Department of the Interior, Bureau of Land Management or by a decree of a Court of Law and/or that the corner points mentioned in lines 3, 4 and 5 above were in conformance with the rules of the Michigan Board of Land Surveyors or by a Decree of a Court of Law, established, re-established, monumented, recovered, found as expressed below:

NOTE: Not more than 2 corners, all in the same town and range, may be recorded on this certificate.

	A	B	C	D	E	F	G	H	I	J	K	L	M
1													
2	6		5		4		3		2		1		
3													
4	7		8		9		10		11		12		
5													
6	18		17		16		15		14		13		
7													
8	19		20		21		22		23		24		
9													
10	30		29		28		27		26		25		
11													
12	31		32		33		34		35		36		
13													

A. Description of original monument and accessories and/or subsequent restoration:

Original corner established by Wells Burt, U.S. Deputy Surveyor, June 19, 1851. Set Wood Post.

ORIGINAL BEARING TREES:

12" Spruce N14°W 21.12 feet
 10" Spruce N48°W 12.54 feet

B. Description of corner evidence found and/or method applied in restoring or reestablishing corner:

No original evidence was found. Corner position is in a county road. Corner was re-established by single proportionate measure and on line between opposite section corners North and South.

Research on file with the Ontonagon County Remonumentation Program Representative.

PLER GROUP APPROVED

Earl W. Applekamp
 COUNTY REPRESENTATIVE

8-13-97

C. Description of monument for corner and accessories established to perpetuate locating the position of the corner:

At the corner position I set a 5/8"x12" rebar with a 3" stamped cap 6" below the gravel surface and in the center-line of the road. I established a reference monument, which is a 2 1/2"x30" aluminum pipe with a 3" cap stamped to read: County Remonumentation, T48N R41W, R.M., 1/4, S22, S23, 1997, P.S. 17610. I also established three other bearing objects.

REF. MON. S56°-40'-26"W 44.89' - 9" Aspen N50°W 70.95'

P. Pole S18°-30'-22"E 106.70' - 26" W. Pine N80°-47'E 53.27'



Signed by Earl W. Applekamp
 Surveyor's Michigan License No. 17610

Date July 31, 1997