


LAND CORNER RECORDATION CERTIFICATE
 Filing Requirement of Act 74, Mich. P.A. 1970

For corners in

| | | |
|------------------------------------|---------------------------|---------------|
| <u>ONTONAGON</u> (County) | Located In: | Corner Code # |
| 1. Public Land Survey | T <u>48N</u> R <u>41W</u> | <u>J-9</u> |
| | T ___ R ___ | _____ |
| | T ___ R ___ | _____ |
| | T ___ R ___ | _____ |
| 2. Property Controlling in Section | S ___ T ___ R ___ | _____ |
| | S ___ T ___ R ___ | _____ |
| 3. Miscellaneous Property in Sec. | S ___ T ___ R ___ | _____ |
| | S ___ T ___ R ___ | _____ |

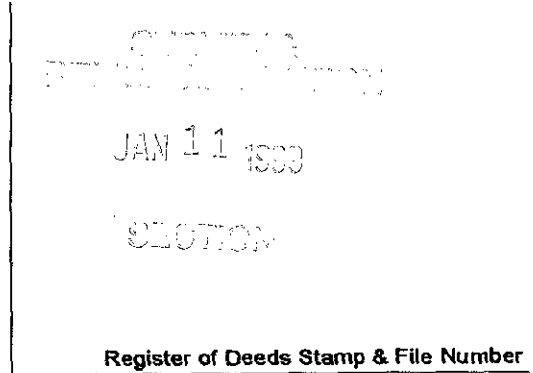

4. Lot No. _____, Recorded Plat _____
 5. Private Claims _____

$\frac{1}{4}$ Corner common to Sections 23 & 26, T48N R41W.

I, Earl W. Applekamp, in a field survey on June 23, 1998 do hereby state that under requirements of P.A. 74, Michigan P.A. of 1970, the corner points mentioned in lines 1 and 2 above were in conformance with regulations and rules therefore as required in the current manual of survey instructions of the United States Department of the Interior, Bureau of Land Management or by a decree of a Court of Law and/or that the corner points mentioned in lines 3, 4 and 5 above were in conformance with the rules of the Michigan Board of Land Surveyors or by a Decree of a Court of Law; established, re-established, monumented, recovered, found as expressed below:

| A | B | C | D | E | F | G | H | I | J | K | L | M |
|----|----|----|----|----|----|----|---|---|---|---|---|---|
| 1 | | | | | | | | | | | | |
| 2 | 6 | 5 | 4 | 3 | 2 | 1 | | | | | | |
| 3 | | | | | | | | | | | | |
| 4 | 7 | 8 | 9 | 10 | 11 | 12 | | | | | | |
| 5 | | | | | | | | | | | | |
| 6 | 19 | 17 | 16 | 15 | 14 | 13 | | | | | | |
| 7 | | | | | | | | | | | | |
| 8 | 19 | 20 | 21 | 22 | 23 | 24 | | | | | | |
| 9 | | | | | | | | | | | | |
| 10 | 30 | 29 | 28 | 27 | 26 | 25 | | | | | | |
| 11 | | | | | | | | | | | | |
| 12 | 31 | 32 | 33 | 34 | 35 | 36 | | | | | | |
| 13 | | | | | | | | | | | | |

NOTE: Not more than 2 corners, all in the same town and range, may be recorded on this certificate.

A. Description of original monument and accessories and/or subsequent restoration:
 Original corner established by Wells Burt, U.S. Deputy Surveyor, June 21, 1851. Set Wood Post.

ORIGINAL BEARING TREES:

| | | |
|----------------|-------|------------|
| 16" White pine | S55°E | 10.56 feet |
| 12" Spruce | N23°E | 12.54 feet |

PEER GROUP APPROVED
Earl W. Applekamp
 COUNTY SURVEYOR
 7-22-98

B. Description of corner evidence found and/or method applied in restoring or reestablishing corner:

No original evidence was found. Apparent corner position is in a road which has been in existence since the 1920's. A split of the section places the corner 7.5 feet West of a well maintained fence line running North and South. These fence lines are occupied lines of 4 different owners. I re-established the corner in the center-line of the road and on line with the fences running North and South.

Research on file with the Ontonagon County Remonumentation Program Representative.

C. Description of monument for corner and accessories established to perpetuate locating the position of the corner:

At the corner position I set a 5/8"x12" rebar with a 3" stamped cap 2" below top of blacktop. The cap is stamped to read: County Remonumentation, T48N R41W, $\frac{1}{4}$, S23, S26, 1998, P.S. 17610. I established a reference monument, a 2 1/2"x30" split base aluminum pipe with a 3" cap stamped to read the same as above. I also established 3 other reference objects.

| | | | | | |
|----------------------|-------|---------|----------------------|-------|---------|
| REF. MON. | S02°W | 36.53' | - Nail in 4" Aspen | N04°E | 32.07' |
| Nail in 7 1/2" Aspen | N67°W | 104.35' | - Nail in Power Pole | S81°E | 149.01' |



Signed by Earl W. Applekamp
 Surveyor's Michigan License No. 17610

Date July 20, 1998