

**LAND CORNER RECORDATION CERTIFICATE**  
 Filing Requirement of Act 74, Mich. P.A. 1970

For corners in


ONTONAGON (County)	Located In:	Corner Code #
1. Public Land Survey	T48N R 41W	K-7
	T R	
	T R	
	T R	
2. Property Controlling in Section	S T R	
	S T R	
3. Miscellaneous Property in Sec.	S T R	
	S T R	

REGISTERED  
 ONTONAGON  
 JAN 11 1999  
 Register of Deeds Stamp & File Number

4. Lot No. \_\_\_\_\_, Recorded Plat \_\_\_\_\_  
 5. Private Claims \_\_\_\_\_

Section Corner common to Sections 13, 14, 23 & 24, T48N R41W.

I, Earl W. Applekamp, in a field survey on June 23, 1998 do hereby state that under requirements of P.A. 74, Michigan P.A. of 1970, the corner points mentioned in lines 1 and 2 above were in conformance with regulations and rules therefore as required in the current manual of survey instructions of the United States Department of the Interior, Bureau of Land Management or by a decree of a Court of Law and/or that the corner points mentioned in lines 3, 4 and 5 above were in conformance with the rules of the Michigan Board of Land Surveyors or by a Decree of a Court of Law; established, re-established, monumented, recovered, found as expressed below:

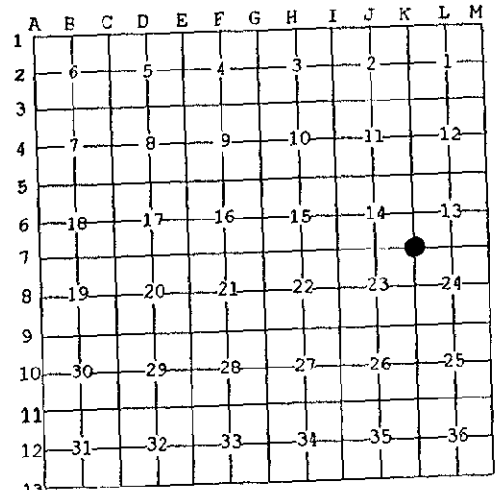

NOTE: Not more than 2 corners, all in the same town and range, may be recorded on this certificate.

A. Description of original monument and accessories and/or subsequent restoration:

Original corner established by Wells Burt, U.S. Deputy Surveyor, June 19, 1851. Set Wood Post.

ORIGINAL BEARING TREES:

36" White Pine	S67°W	14.52 feet
40" White Pine	N38°E	17.82 feet

PEER GROUP APPROVED  
*Earl W. Applekamp*  
 COUNTY REPRESENTATIVE  
 7-22-98

B. Description of corner evidence found and/or method applied in restoring or reestablishing corner:


No original evidence remains. Area has been farmed since the 1920's. At the corner position is an occupied well maintained fence going North & East. This position is in conformance with the original survey notes. I re-established the corner at the occupied fence corner. This is the only logical position for the corner.

Research on file with the Ontonagon County Remonumentation Program Representative.

C. Description of monument for corner and accessories established to perpetuate locating the position of the corner:

At the corner position I set a 2 1/2"x30" split base aluminum pipe with a 3" cap stamped to read: County Remonumentation, T48N R41W, S13, S14, S23, S24, 1998, P.S. 17610. I established 3 bearing trees and a reference object.

Nail in 6" Aspen	S23°W	132.22'	- Nail in 8" MAPLE	S42°E	184.89'
Nail in 7 1/2" Aspen	N84°W	141.00'	- 6' Steel Sign Post,	Due East	0.60'

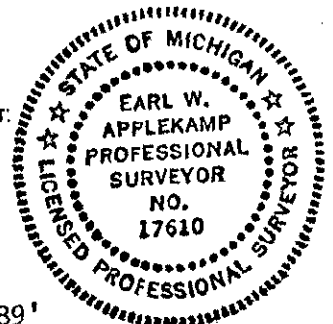

Signed by Earl W. Applekamp  
 Surveyor's Michigan License No. 17610

Date July 20, 1998