


LAND CORNER RECORDATION CERTIFICATE
 Filing Requirement of Act 74, Mich. P.A. 1970

For corners in

<u>ONTONAGON</u> (County)	Located in:	Corner Code #
1. Public Land Survey	T48N R 41W	K-8
	T ___ R ___	_____
	T ___ R ___	_____
	T ___ R ___	_____
2. Property Controlling in Section	S ___ T ___ R ___	_____
	S ___ T ___ R ___	_____
3. Miscellaneous Property in Sec.	S ___ T ___ R ___	_____
	S ___ T ___ R ___	_____

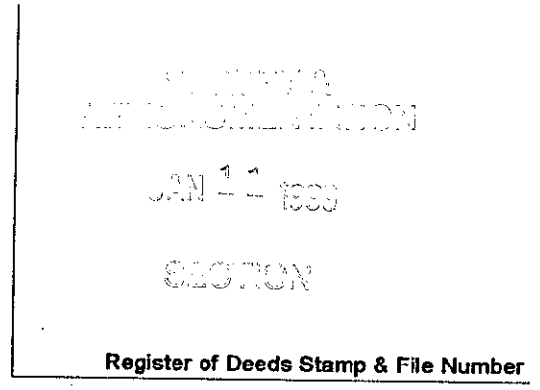

4. Lot No. _____, Recorded Plat _____
 5. Private Claims _____

$\frac{1}{4}$ Corner common to Sections 23 & 24, T48N R41W.

I, Earl W. Applekamp, in a field survey on June 23, 1998 do hereby state that under requirements of P.A. 74, Michigan P.A. of 1970, the corner points mentioned in lines 1 and 2 above were in conformance with regulations and rules therefore as required in the current manual of survey instructions of the United States Department of the Interior, Bureau of Land Management or by a decree of a Court of Law and/or that the corner points mentioned in lines 3, 4 and 5 above were in conformance with the rules of the Michigan Board of Land Surveyors or by a Decree of a Court of Law; established, re-established, monumented, recovered, found as expressed below.

NOTE: Not more than 2 corners, all in the same town and range, may be recorded on this certificate.

A	B	C	D	E	F	G	H	I	J	K	L	M
1												
2	6		5		4		3		2		1	
3												
4	7		8		9		10		11		12	
5												
6	16		17		16		15		14		13	
7												
8	19		20		21		22		23		24	
9												
10	30		29		28		27		26		25	
11												
12	31		32		33		34		35		36	
13												

A. Description of original monument and accessories and/or subsequent restoration:

Original corner established by Wells Burt, U.S. Deputy Surveyor, June 21, 1851. Set Wood Post.

ORIGINAL BEARING TREES:

20" White Pine S34°W 9.24 feet
 30" White Pine S25°E 13.20 feet

ONTONAGON COUNTY
PEER APPROVED

Earl W. Applekamp
 Ont. Co. Rep
 7-22-98

B. Description of corner evidence found and/or method applied in restoring or reestablishing corner:

No original evidence was found. Area has been cleared for farming. A split of the Section places the corner in the center-line of a dirt road and on line with a fence running West. I re-established the corner by single proportionate measure and on line between opposite section corners North and South.

Research on file with the Ontonagon County Remonumentation Program Representative.

C. Description of monument for corner and accessories established to perpetuate locating the position of the corner:

At the corner position I set a 2 $\frac{1}{2}$ "X30" split base aluminum pipe with a 3" cap stamped to read: County Remonumentation, T48N R41W, $\frac{1}{4}$, S23, S24, 1998, P.S. 17610. I established 3 bearing trees and a reference object.

Nail in 16" Aspen S56°W 89.25' - Nail in 10" Aspen N73°E 82.13'
 Nail in 11" Aspen N31°E 110.84' - 6' Steel Sign Post Due South 0.97'



Signed by Earl W. Applekamp
 Surveyor's Michigan License No. 17610

Date July 20, 1998