


**LAND CORNER RECORDATION CERTIFICATE**  
**Filing Requirement of Act 74, Mich. P.A. 1970**

For corners in

<u>ONTONAGON</u> (County)	Located In:	Corner Code #
1. Public Land Survey	T48N R 41W	L-5
	T ___ R ___	_____
	T ___ R ___	_____
	T ___ R ___	_____
2. Property Controlling in Section	S ___ T ___ R ___	_____
	S ___ T ___ R ___	_____
3. Miscellaneous Property In Sec.	S ___ T ___ R ___	_____
	S ___ T ___ R ___	_____

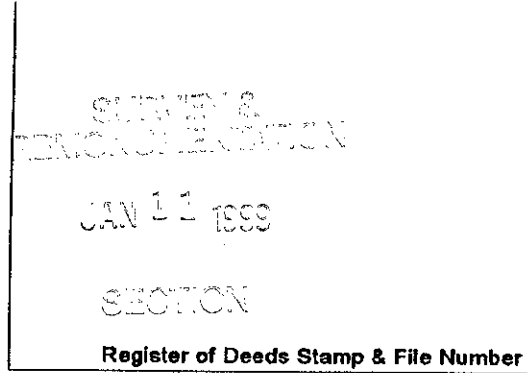

4. Lot No. \_\_\_\_\_, Recorded Plat \_\_\_\_\_  
 5. Private Claims \_\_\_\_\_

1/4 Corner common to Sections 12 & 13, T48N R41W.

I, Earl W. Applekamp, in a field survey on June 30, 1998 do hereby state that under requirements of P.A. 74, Michigan P.A. of 1970, the corner points mentioned in lines 1 and 2 above were in conformance with regulations and rules therefore as required in the current manual of survey instructions of the United States Department of the Interior, Bureau of Land Management or by a decree of a Court of Law and /or that the corner points mentioned in lines 3, 4 and 5 above were in conformance with the rules of the Michigan Board of Land Surveyors or by a Decree of a Court of Law; established, re-established, monumented, recovered, found as expressed below:

NOTE: Not more than 2 corners, all in the same town and range, may be recorded on this certificate.

	A	B	C	D	E	F	G	H	I	J	K	L	M
1													
2	6		5		4		3		2		1		
3													
4	7		8		9		10		11		12		
5													
6	18		17		16		15		14		13		
7													
8	19		20		21		22		23		24		
9													
10	30		29		28		27		26		25		
11													
12	31		32		33		34		35		36		
13													

A. Description of original monument and accessories and/or subsequent restoration:

Original corner established by Wells Burt, U.S. Deputy Surveyor, June 30, 1851. Set Wood Post.

ORIGINAL BEARING TREES:

16" Maple S77°E 13.20 feet  
 20" Yellow Birch S45°W 12.54 feet

DEED GROUP APPROVAL  
*Earl W. Applekamp*  
 COUNTY REPRESENTATIVE  
 8-19-98

B. Description of corner evidence found and/or method applied in restoring or reestablishing corner:


No original evidence was found. A well maintained fence running East and South enclosing an occupied farm was at the calculated position. I monumented the intersection of the fence lines.

Research on file with the Ontonagon County Remonumentation Program Representative.

C. Description of monument for corner and accessories established to perpetuate locating the position of the corner:

At the corner position I set a 2 1/2" X 30" split base aluminum pipe with a 3" cap stamped to read: County Remonumentation, T48N R41W, 1/4, S12, S13, 1998, P.S. 17610. I established 3 bearing trees and a reference object.

Nail in 7" Aspen S03°W 78.68' - Nail in 5" Maple N58°E 115.21'  
 Nail in 8" Aspen Due West 77.08' - 6' Steel Sign Post Due North 0.75'

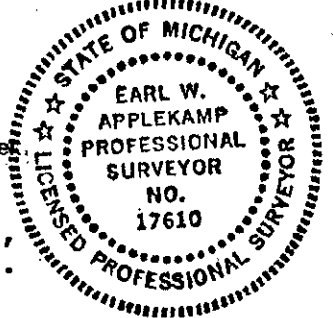

Signed by Earl W. Applekamp  
 Surveyor's Michigan License No. 17610

Date July 18, 1998