


**LAND CORNER RECORDATION CERTIFICATE**  
 Filing Requirement of Act 74, Mich. P.A. 1970

For corners in

<u>ONTONAGON</u> (County)	Located In:	Corner Code #
1. Public Land Survey	T48N R41W	L-7
	T___ R___	_____
	T___ R___	_____
	T___ R___	_____
2. Property Controlling in Section	S___ T___ R___	_____
	S___ T___ R___	_____
3. Miscellaneous Property in Sec.	S___ T___ R___	_____
	S___ T___ R___	_____

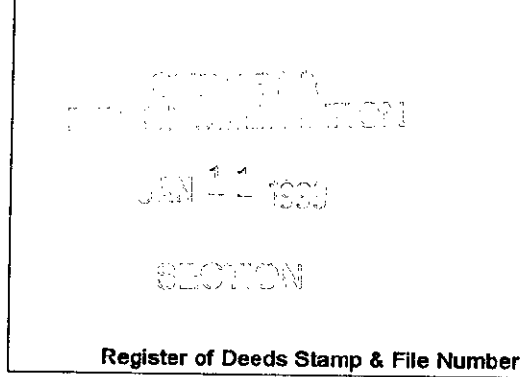

4. Lot No. \_\_\_\_\_, Recorded Plat \_\_\_\_\_  
 5. Private Claims \_\_\_\_\_

$\frac{1}{4}$  Corner common to Sections 13 & 24, T48N R41W.

I, Earl W. Applekamp, in a field survey on June 25, 1998 do hereby state that under requirements of P.A. 74, Michigan P.A. of 1970, the corner points mentioned in lines 1 and 2 above were in conformance with regulations and rules therefore as required in the current manual of survey instructions of the United States Department of the Interior, Bureau of Land Management or by a decree of a Court of Law and /or that the corner points mentioned in lines 3, 4 and 5 above were in conformance with the rules of the Michigan Board of Land Surveyors or by a Decree of a Court of Law; established, re-established, monumented, recovered, found as expressed below:

NOTE: Not more than 2 corners, all in the same town and range, may be recorded on this certificate.

	A	B	C	D	E	F	G	H	I	J	K	L	M
1													
2	6		5		4		3		2		1		
3													
4	7		8		9		10		11		12		
5													
6	18		17		16		15		14		13		
7													
8	19		20		21		22		23		24		
9													
10	30		29		28		27		26		25		
11													
12	31		32		33		34		35		36		
13													

A. Description of original monument and accessories and/or subsequent restoration:

Original corner established by Wells Burt, U.S. Deputy Surveyor, June 21, 1851. Set Wood Post.

ORIGINAL BEARING TREES:

14" Spruce N88°E 10.56 feet  
 16" Cedar S30°W 27.06 feet

PEER GROUP APPROVED  
*Earl W. Applekamp*  
 COUNTY REPRESENTATIVE

7-22-98

B. Description of corner evidence found and/or method applied in restoring or reestablishing corner:


No original evidence was found. Corner position falls in an abandoned graded up road which was never graveled. From this position a well maintained fence runs West beginning at a point about 33 feet West of the corner position. I re-established the corner by single proportionate measure and on line between opposite Section Corners East and West.

Research on file with the Ontonagon County Remonumentation Program Representative.

C. Description of monument for corner and accessories established to perpetuate locating the position of the corner:

At the corner position I set a 2 $\frac{1}{2}$ "X30" split base aluminum pipe with a 3" cap stamped to read: County Remonumentation, T48N R41W,  $\frac{1}{4}$ , S13, S24, 1998, P.S. 17610. I established 3 bearing trees and a reference object.

Nail in 9" Aspen N20°E 93.19' - Nail in 12" Aspen S19°E 112.29'  
 Nail in 7" Aspen S57°E 36.95' - 6' Sign Post Due West 0.79'

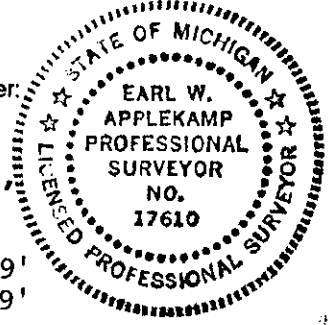

Signed by Earl W. Applekamp  
 Surveyor's Michigan License No. 17610

Date June 20, 1998