


SURVEY &
REMONUMENTATION

FEB 16 1999

RANDOM & OTHER CORNERS

T. 48 N., R. 42 W.

SECTION

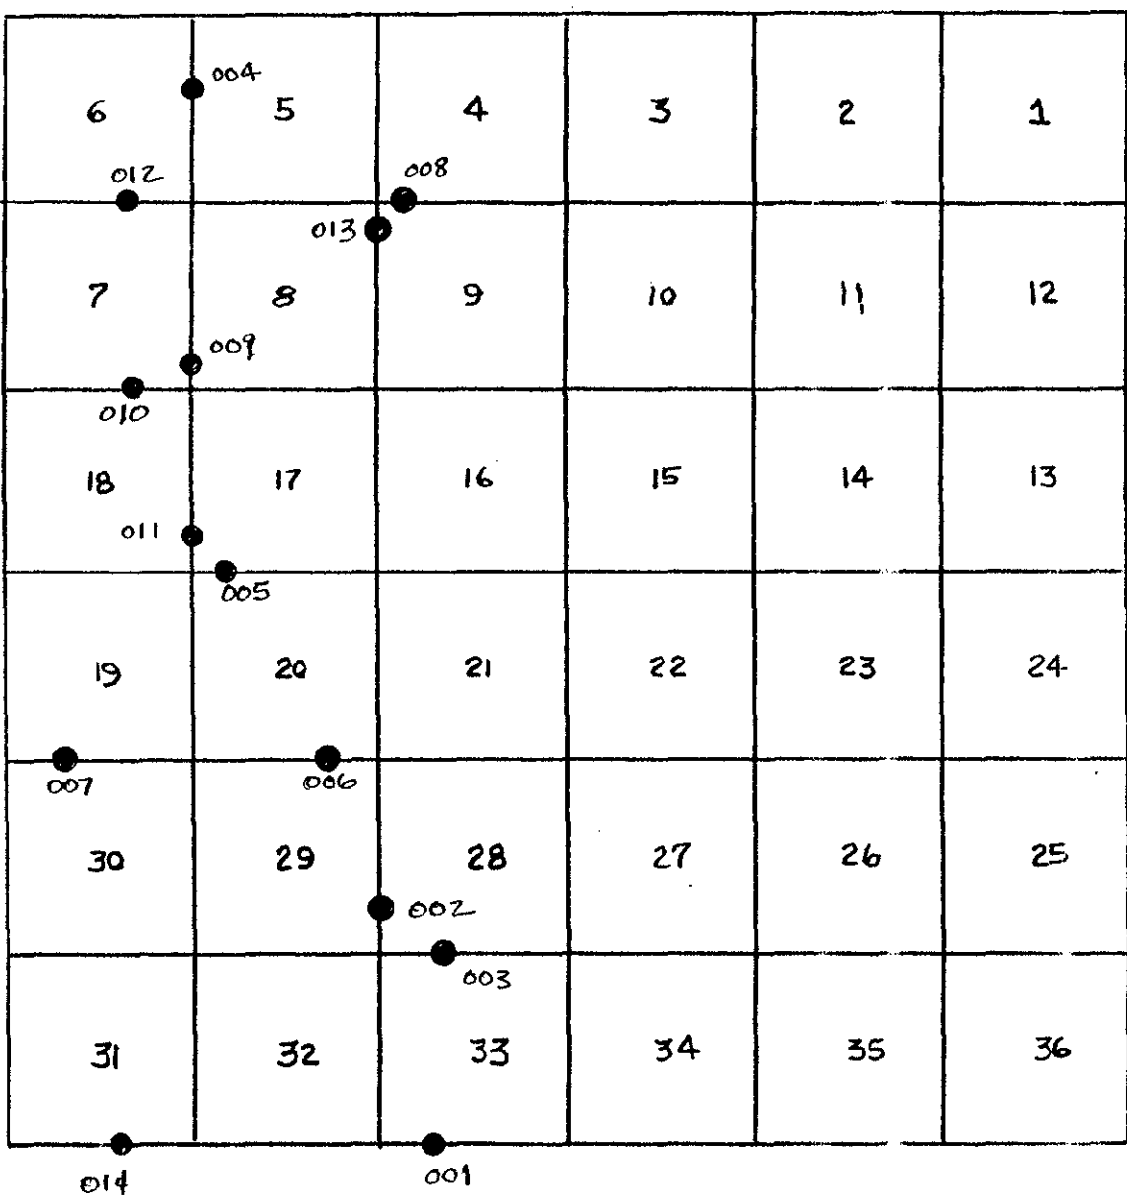

● RANDOM & OTHER CORNERS MONUMENTED

ONTONOGAN