


NEKT # 012

Township 48 North Range 42 West

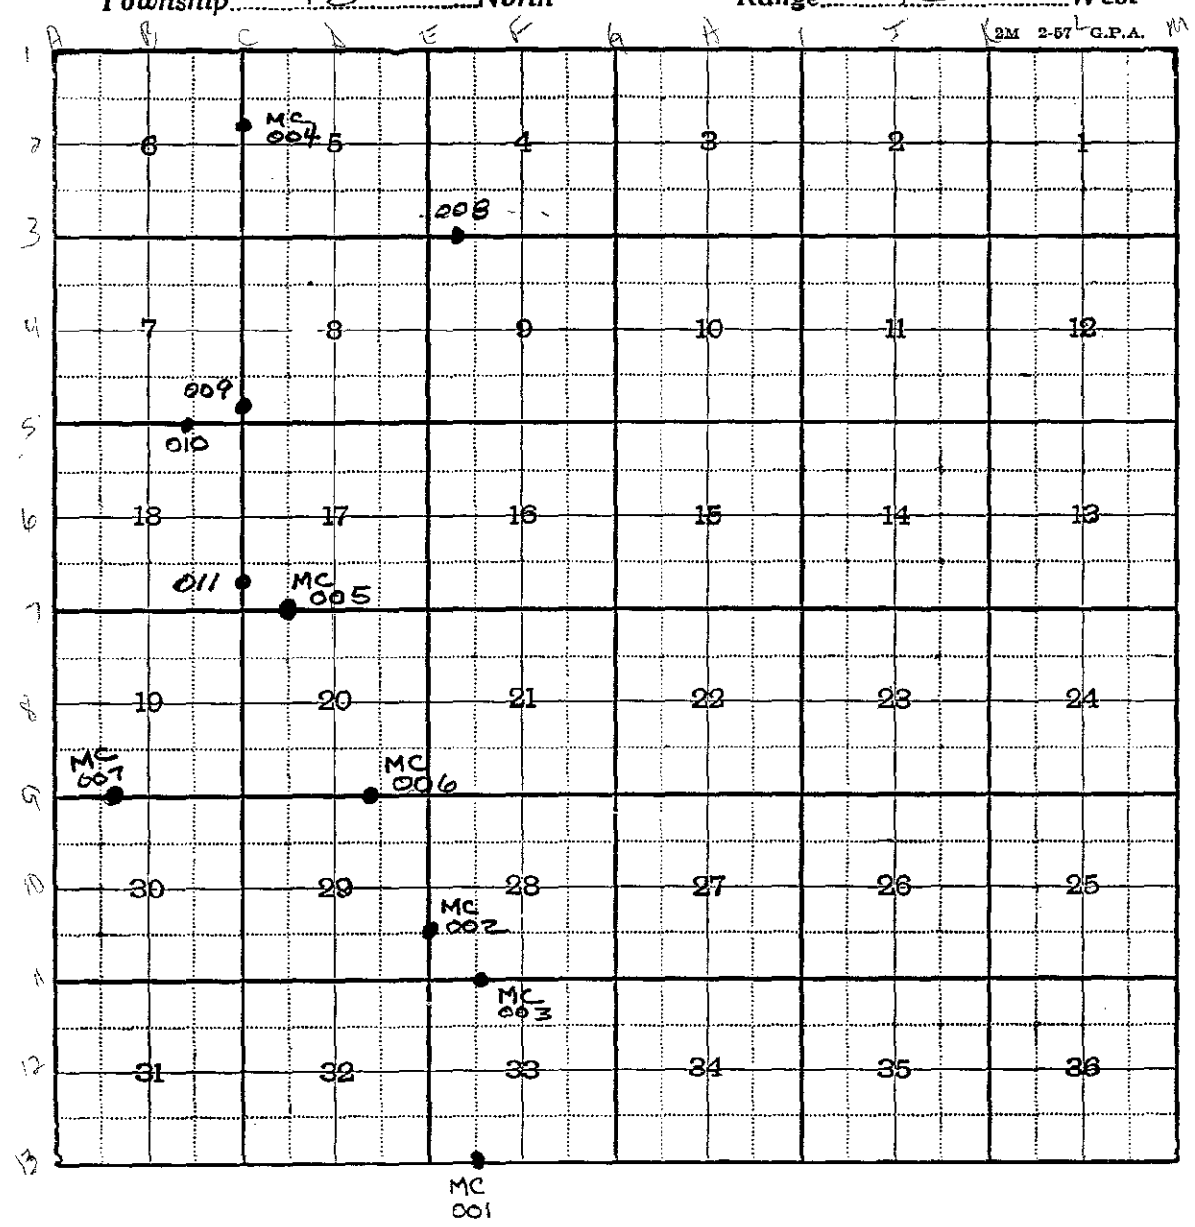

Ontonogan Co.